


# CITY OF SALFORD UNITARY DEVELOPMENT PLAN REVIEW PROPOSED MODIFICATION TO THE PROPOSALS MAP

- Address: Land at the junction of Vicars Hall Lane & Leigh Road, Worsley & Boothstown  
- Policy: Policy EHC8  
- Modification: Delete the policy from the Proposals Map

MOD 535

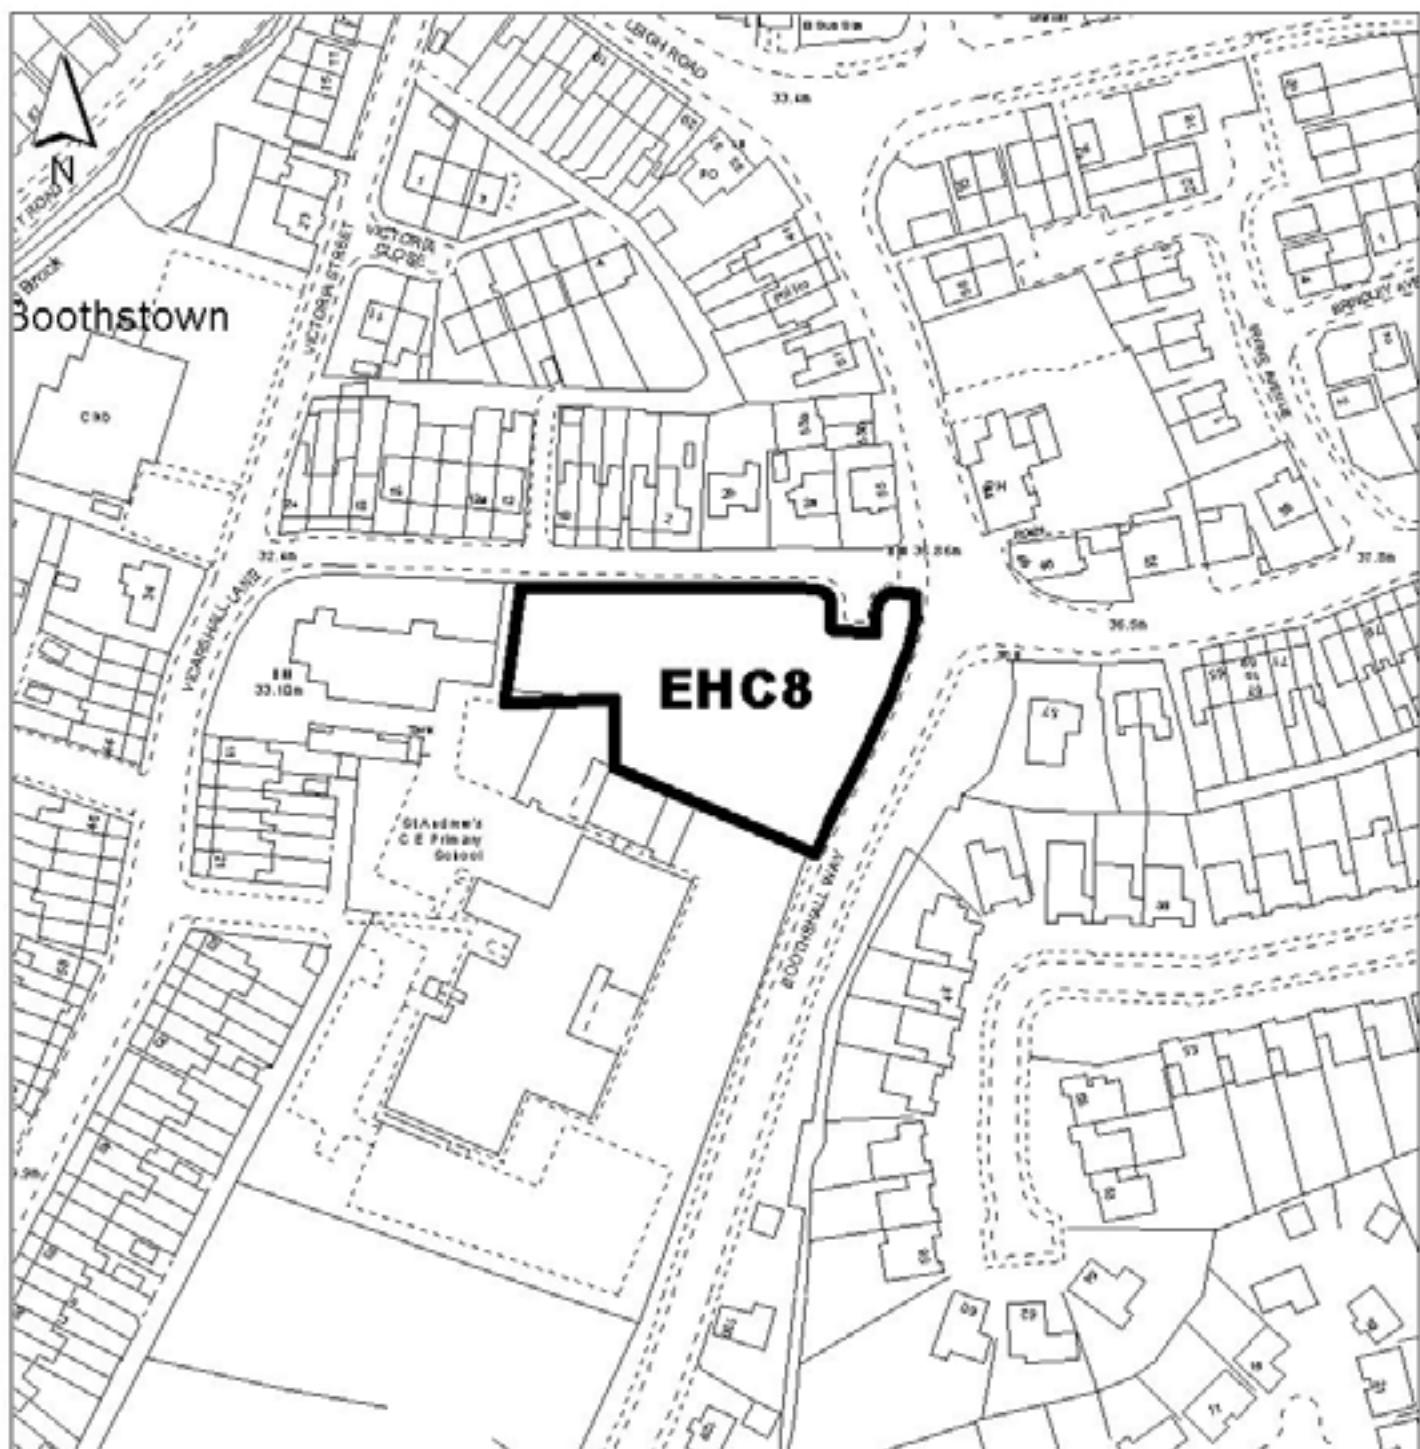

Salford City Council

Development Planning Section,  
Development Services,  
Salford Civic Centre, Chorley Rd,  
Swinton, Salford M27 6BW.  
[www.salford.gov.uk](http://www.salford.gov.uk)

Job:	Project:	Drawing No.
Drawn:		
Checked:		
Scale:	1:1500	
Date:	Oct 2005	
Filename:	UDPMOD	
Title:		Revision


\*Reproduced from the Ordnance Survey mapping with the permission of the Controller of Her Majesty's Stationery Office © Crown copyright.  
Unauthorised reproduction infringes Crown copyright and may lead to prosecution or civil proceedings. Salford City Council. Licence No. 100019737. 2004.

udp.modification to proposals map.apr

# CITY OF SALFORD UNITARY DEVELOPMENT PLAN REVIEW PROPOSED MODIFICATION TO THE PROPOSALS MAP

- Address: The A57 - M62 Barton Moss link road
- Policy: Policy A9/3
- Modification: Delete the policy from the Proposals Map

MOD 536

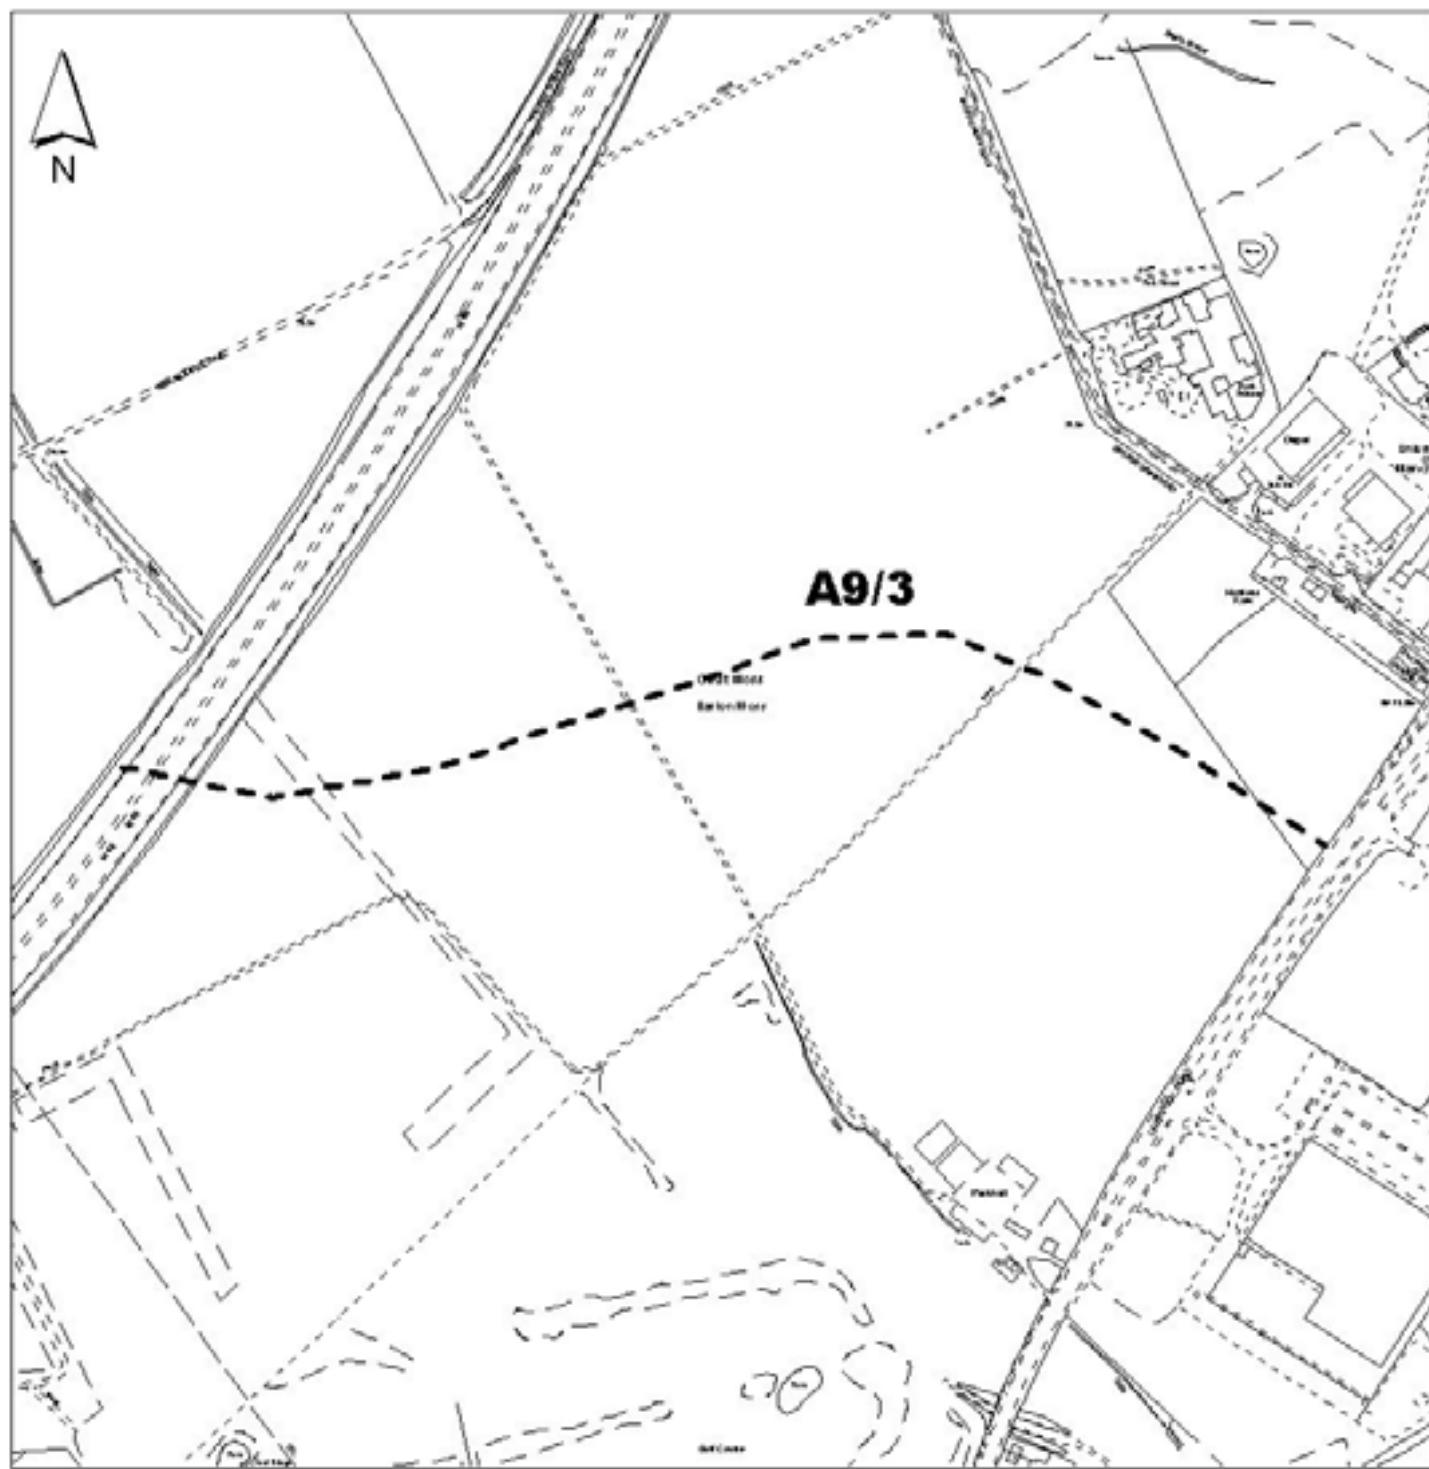

Salford City Council


Development Planning Section,  
Development Services,  
Salford Civic Centre, Chorley Rd,  
Swinton, Salford M27 0BW.  
[www.salford.gov.uk](http://www.salford.gov.uk)

Job:	Project:	Drawing No.:
Drawn:		
Checked:		
Scale: 1:5500	Title:	
Date: Oct 2005		Revision:
Filename: UDPMOD		

# CITY OF SALFORD UNITARY DEVELOPMENT PLAN REVIEW PROPOSED MODIFICATION TO THE PROPOSALS MAP

- Address: A580 - B5231 Link Road (East Lancashire Road to Rocky Lane)
- Policy: Policy A9/5
- Modification: Delete the policy from the Proposals Map

MOD 537

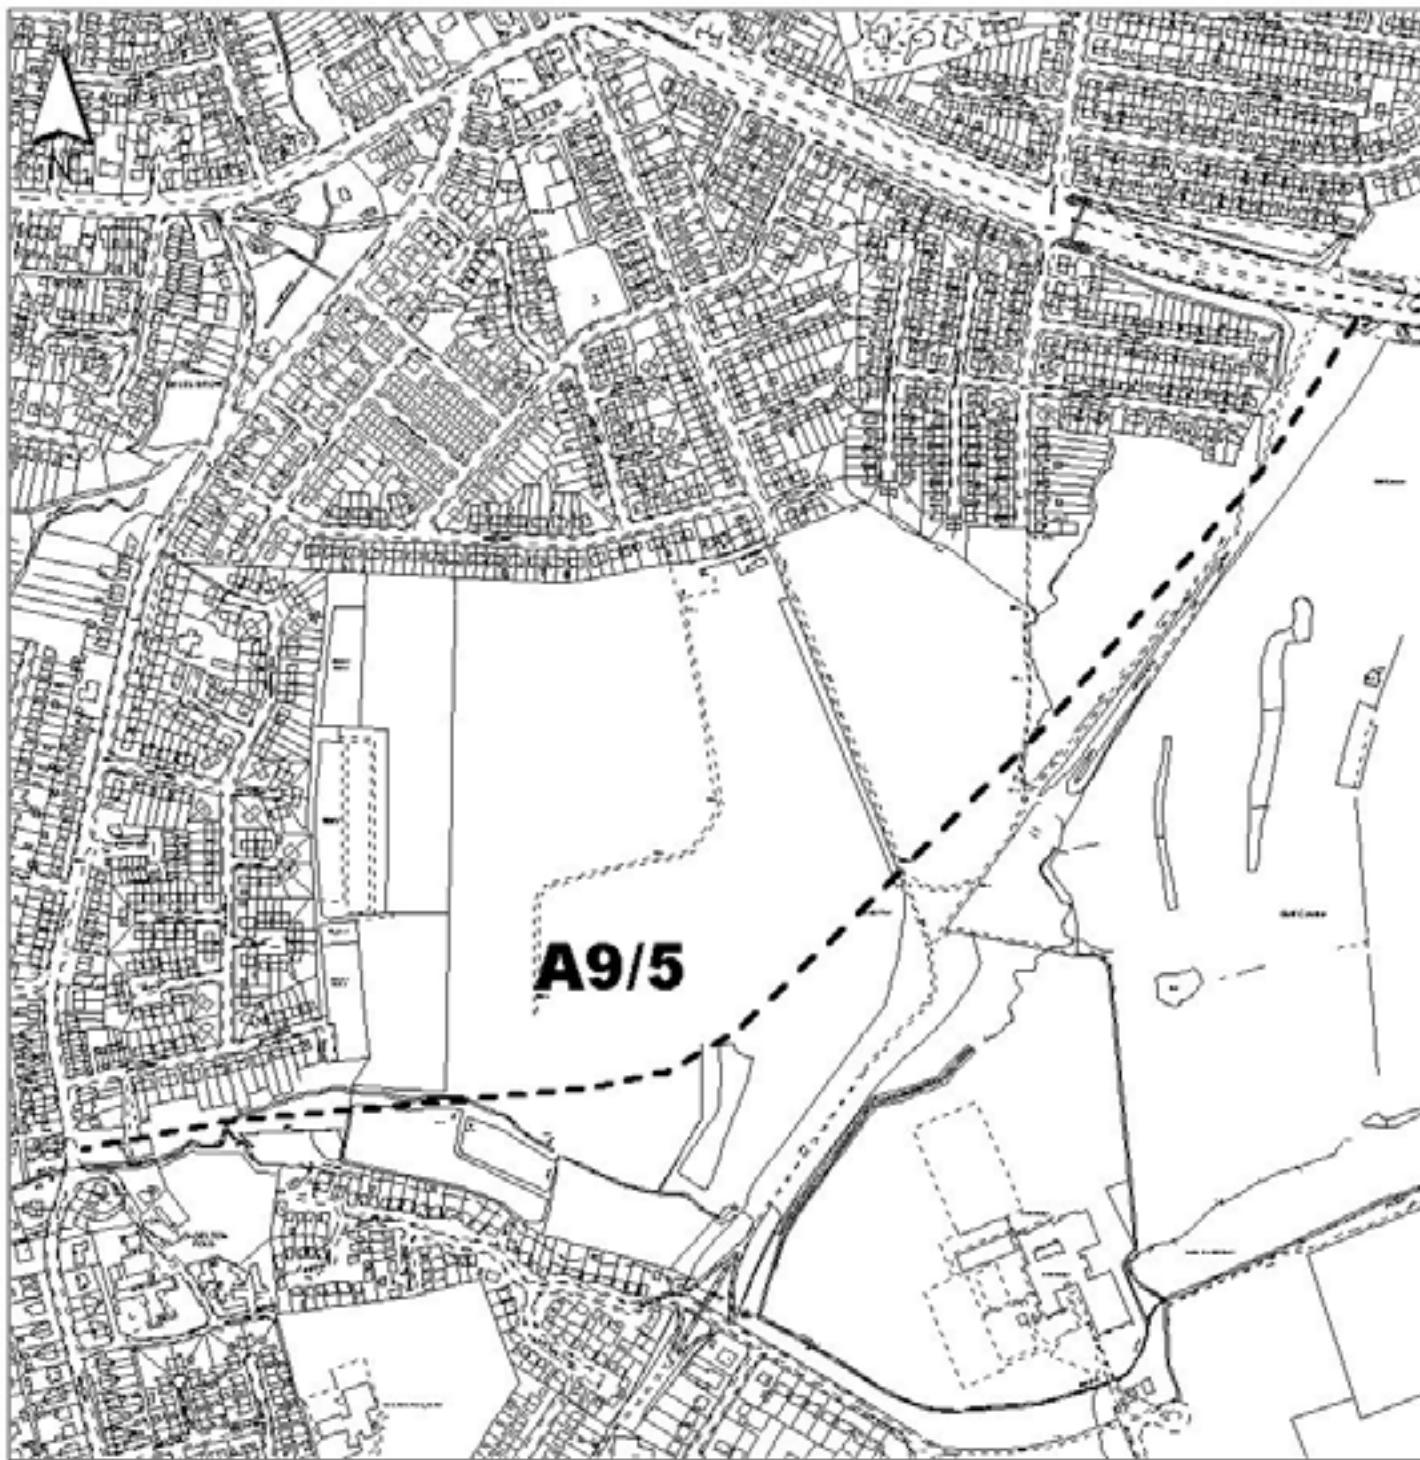

Salford City Council

Development Planning Section,  
Development Services,  
Salford Civic Centre, Chorley Rd,  
Swinton, Salford M27 6BW.  
[www.salford.gov.uk](http://www.salford.gov.uk)

Job:	Project:	Drawing No.
Drawn:		
Checked:		
Scale: 1:6000	Title:	Revision
Date: Oct 2005		
Filename: UDPMOD		


\*Reproduced from the Ordnance Survey mapping with the permission of the Controller of Her Majesty's Stationery Office © Crown copyright.  
Unauthorised reproduction infringes Crown copyright and may lead to prosecution or civil proceedings. Salford City Council Licence No. 100019737. 2004.

UDP modification to proposals map

# CITY OF SALFORD UNITARY DEVELOPMENT PLAN REVIEW PROPOSED MODIFICATION TO THE PROPOSALS MAP

- Address: A57 - A6144 Link road and lift bridge (Cadishead Way (Salford) to Manchester Road (Trafford))
- Policy: Policy A9/6
- Modification: Delete the policy from the Proposals Map

MOD 538

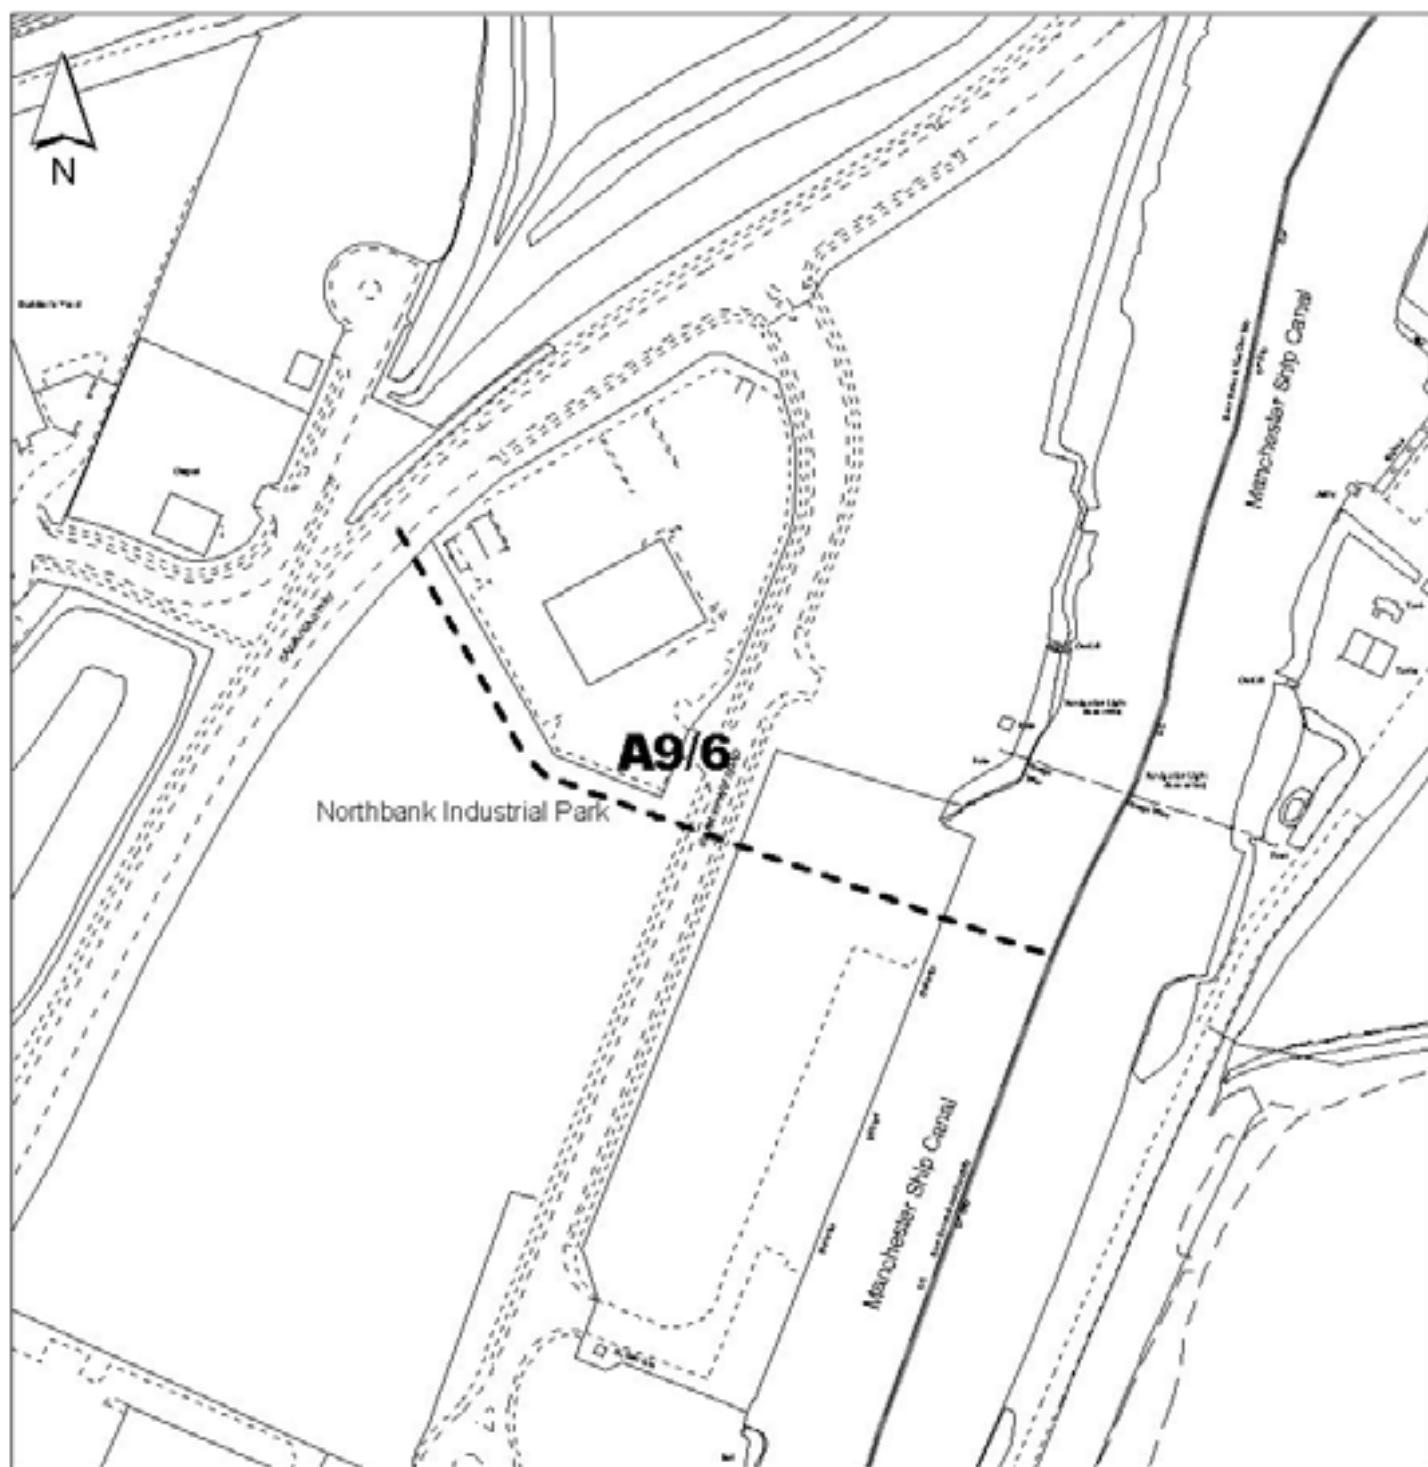

Salford City Council


Development Planning Section,  
Development Services,  
Salford Civic Centre, Chorley Rd,  
Swinton, Salford M27 8BW.  
[www.salford.gov.uk](http://www.salford.gov.uk)

Job:	Project:	Drawing No.:
Drawn:		
Checked:		
Scale 1:2500		
Date Oct 2005		
Filename: UDPMOD		
	Title:	Revision:

# CITY OF SALFORD UNITARY DEVELOPMENT PLAN REVIEW PROPOSED MODIFICATION TO THE PROPOSALS MAP

- Address: Irwell Valley (Land at Rake Lane)
- Policy: Policy EN6
- Modification: Delete land within the garden of number 279 Rake Lane, Clifton, from the policy area

MOD 539

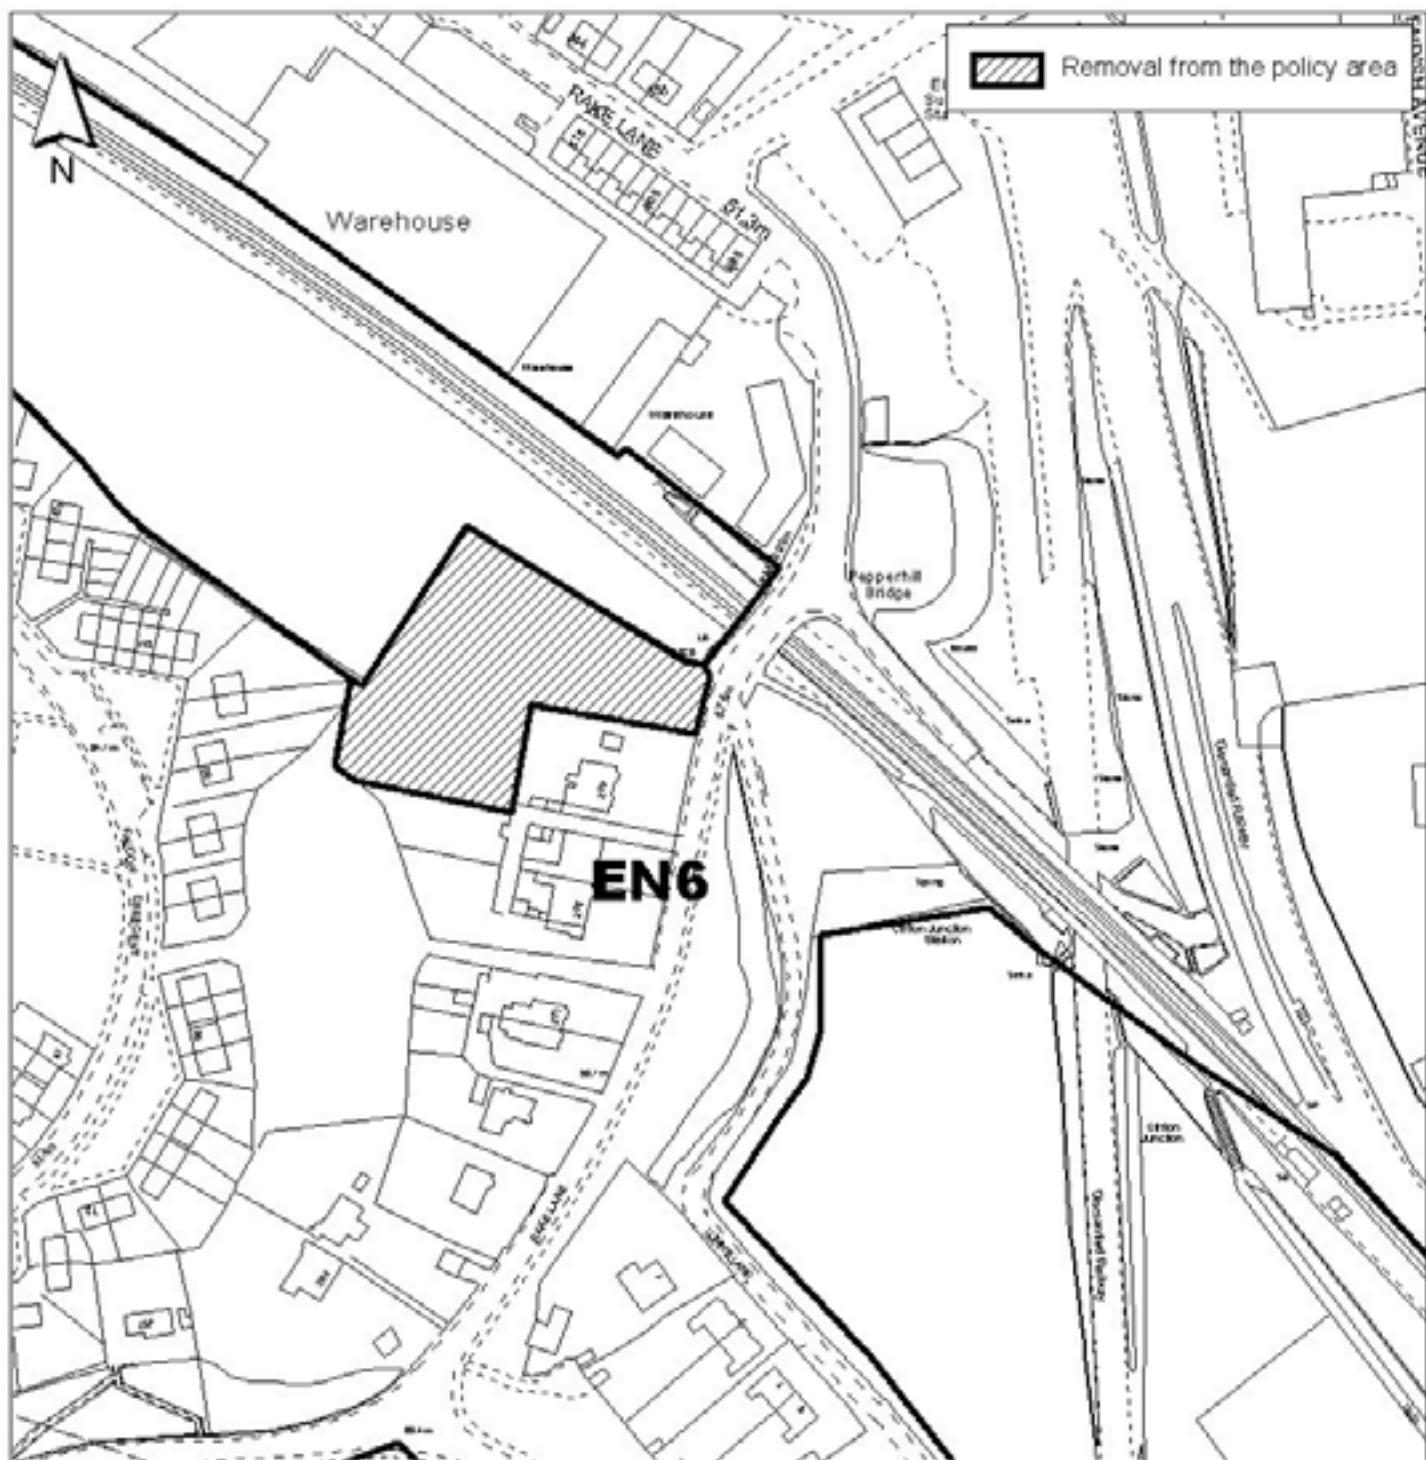

Salford City Council

Development Planning Section,  
Development Services,  
Salford Civic Centre, Chorley Rd,  
Swinton, Salford M27 6BW,  
[www.salford.gov.uk](http://www.salford.gov.uk)

Job:	Project:	Drawing No.:
Drawn:		
Checked:		
Scale: 1:2000		
Date: Oct 2005	Title:	Revision:
Filename: UDPMOD		


\*Reproduced from the Ordnance Survey mapping with the permission of the Controller of Her Majesty's Stationery Office © Crown copyright.  
Unauthorised reproduction infringes Crown copyright and may lead to prosecution or civil proceedings. Salford City Council Licence No. 100019737. 2004.

UDP modification to proposals map.apr

# CITY OF SALFORD UNITARY DEVELOPMENT PLAN REVIEW PROPOSED MODIFICATION TO THE PROPOSALS MAP

- Address:      **Twelve Yards Road, Irlam**
- Policy:        **Policy EN7C**
- Modification: **Allocate land at Twelve Yards Road as a Site of Biological Importance**

**MOD 540**

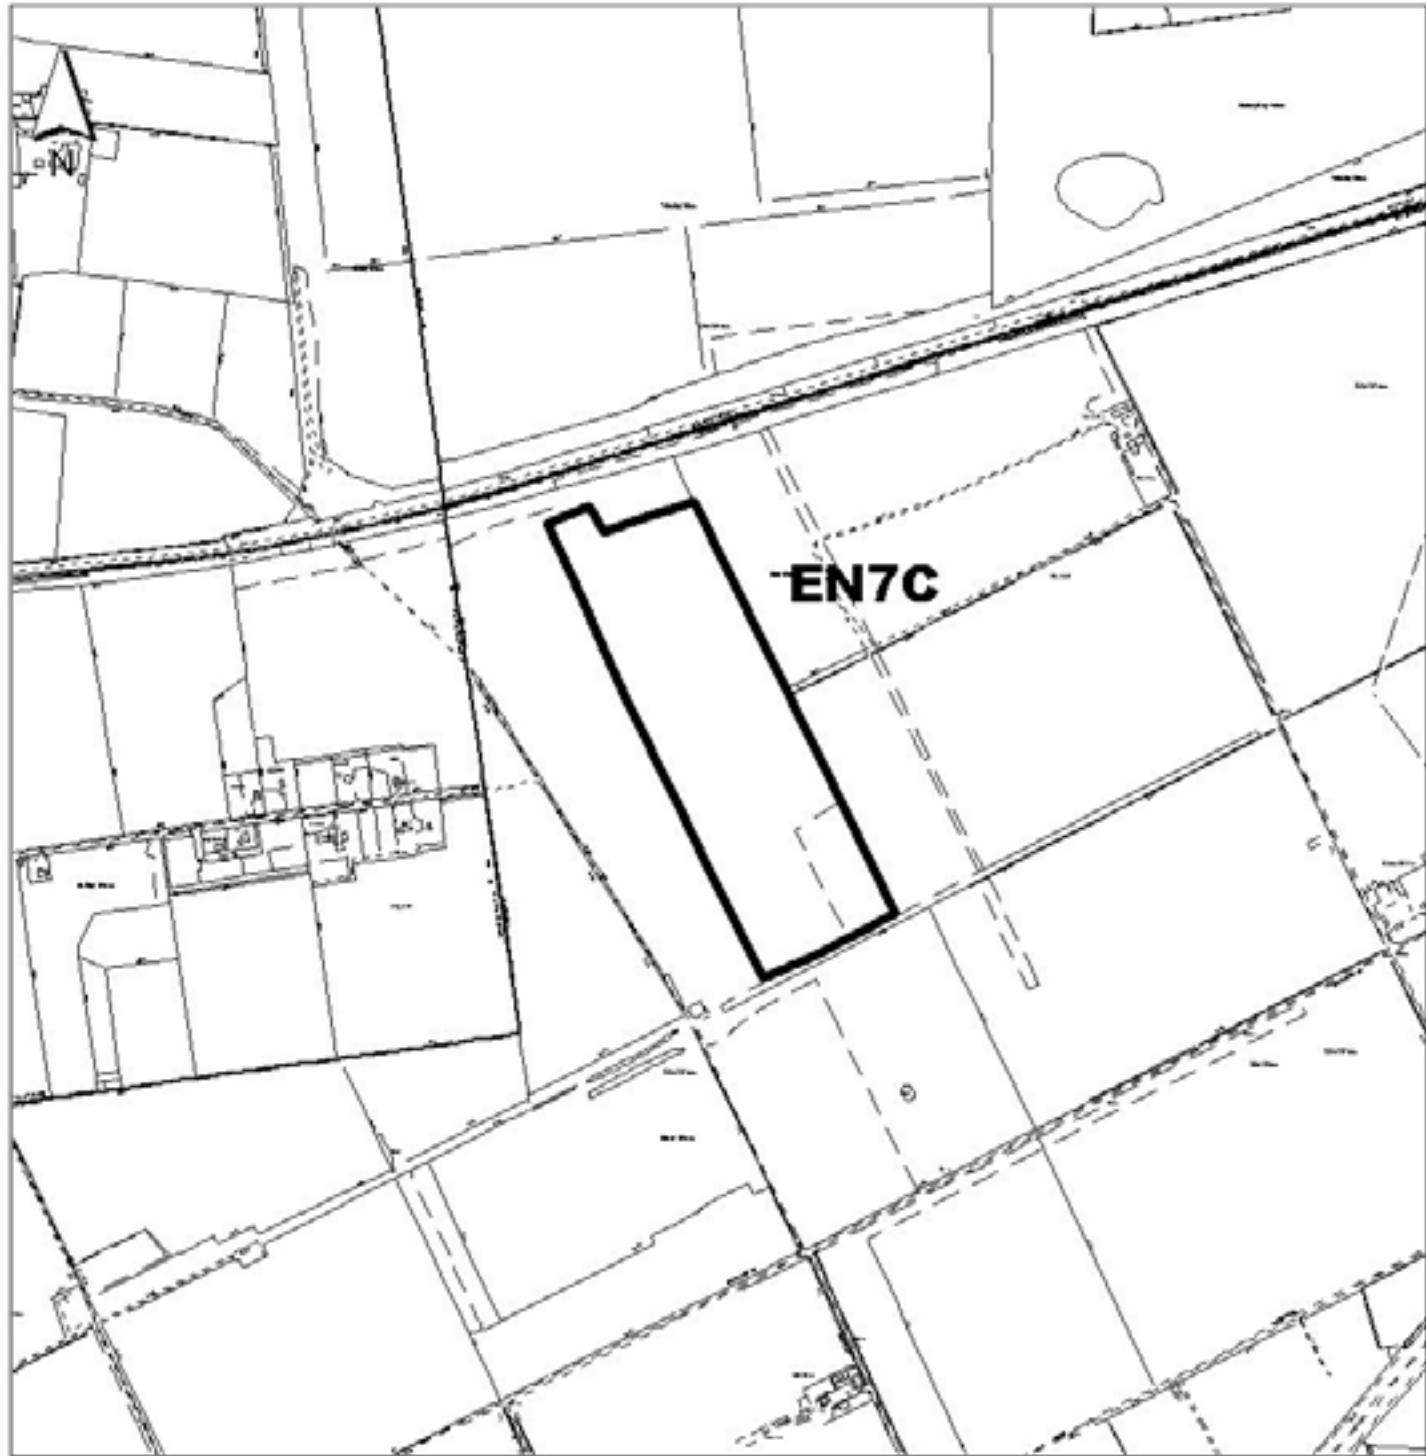

Salford City Council

Development Planning Section,  
Development Services,  
Salford Civic Centre, Chorley Rd,  
Swinton, Salford M27 6BW,  
[www.salford.gov.uk](http://www.salford.gov.uk)

Job:	Project:	Drawing No.
Drawn:		
Checked:		
Scale:	1:11000	Title:
Date:	Oct 2005	Revision:
Filename:	UDPMOD	


\*Reproduced from the Ordnance Survey mapping with the permission of the Controller of Her Majesty's Stationery Office © Crown copyright.  
Unauthorised reproduction infringes Crown copyright and may lead to prosecution or civil proceedings. Salford City Council Licence No. 100019737. 2004.

Map modified to propose map ap

# CITY OF SALFORD UNITARY DEVELOPMENT PLAN REVIEW PROPOSED MODIFICATION TO THE PROPOSALS MAP

MOD 541

- Address: Wildlife Corridor (Land at Rake Lane)
- Policy: Policy EN7D
- Modification: Delete land within the garden of number 279 Rake Lane, Clifton, from the Wildlife Corridor Key Area of Search

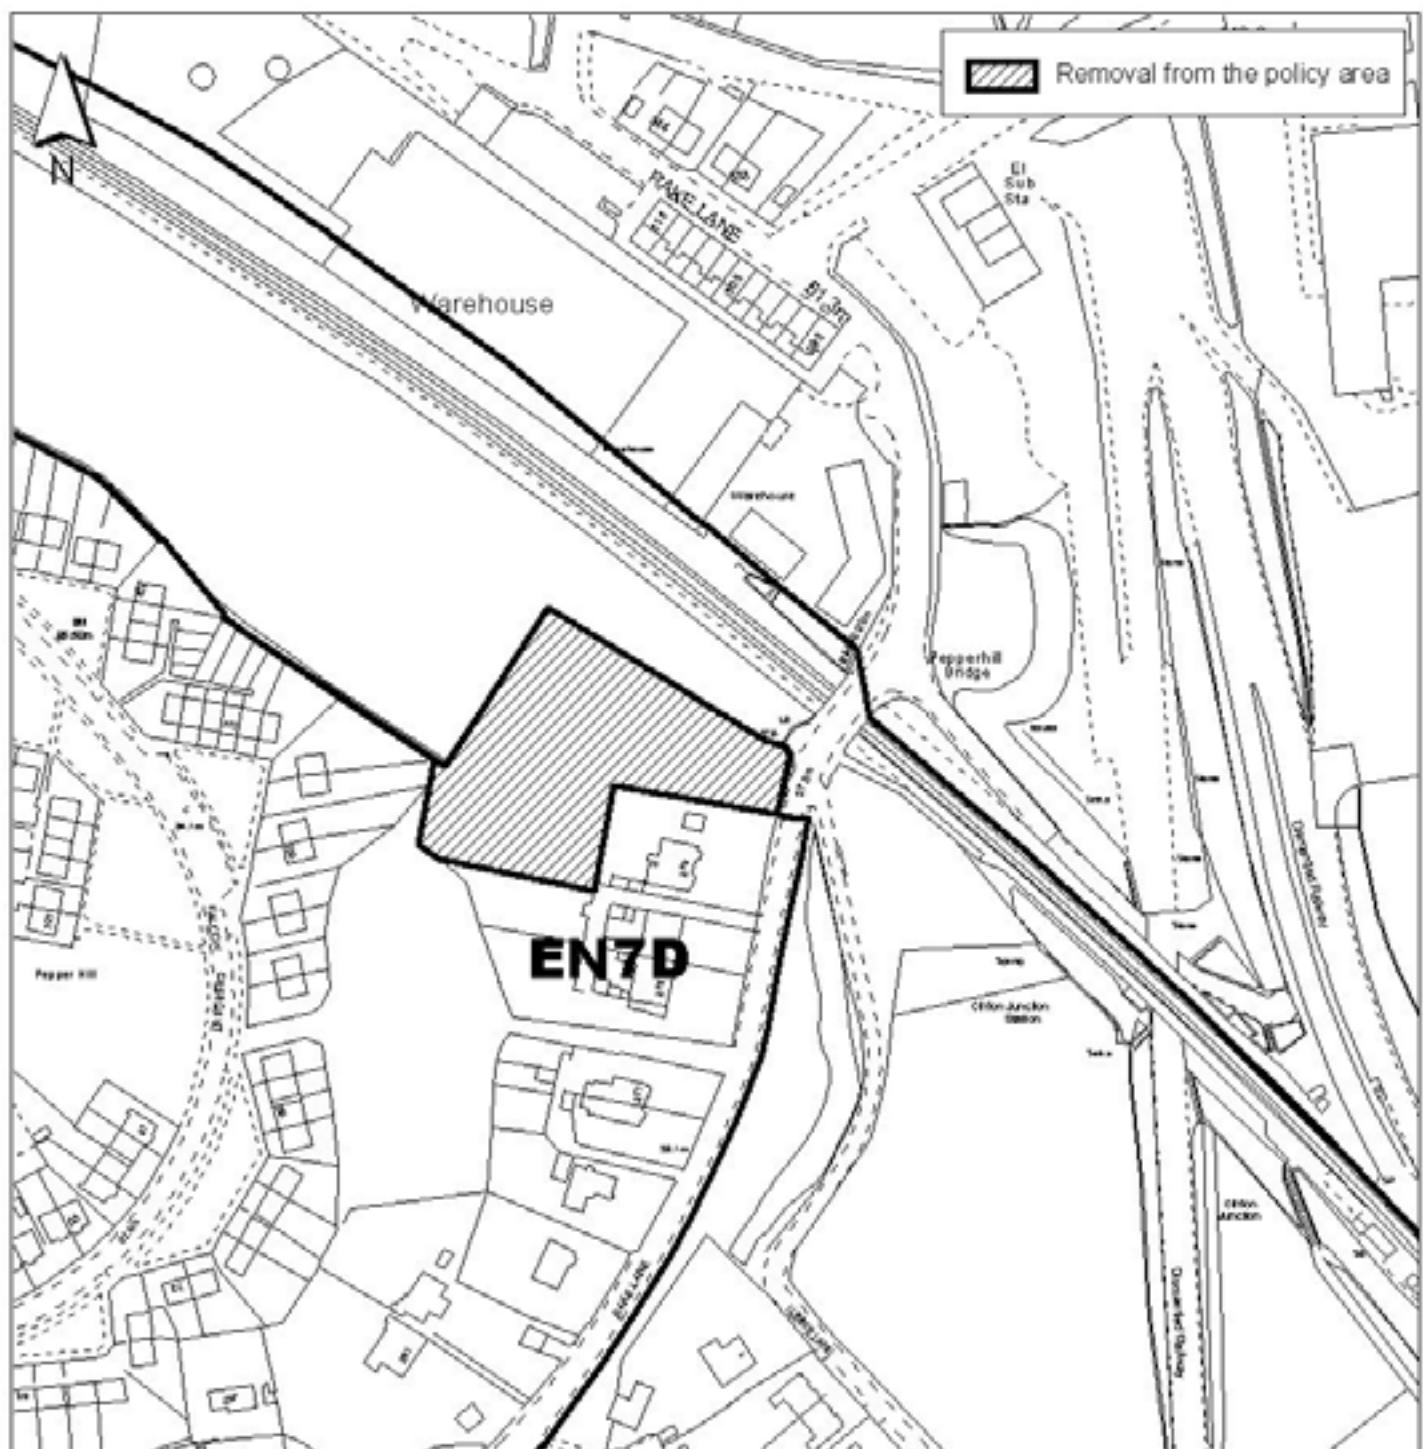

Salford City Council

Development Planning Section,  
Development Services,  
Salford Civic Centre, Chorley Rd,  
Swinton, Salford M27 6BW.  
[www.salford.gov.uk](http://www.salford.gov.uk)

Job:	Project:	Drawing No.
Drawn:		
Checked:		
Scale: 1:2000		
Date: Oct 2005	Title:	Revision
Filename: UDPM002		


\*Reproduced from the Ordnance Survey mapping with the permission of the Controller of Her Majesty's Stationery Office © Crown copyright.  
Unauthorised reproduction infringes Crown copyright and may lead to prosecution or civil proceedings. Salford City Council. Licence No. 100019737. 2004.

udp modification to proposals map.apr

# CITY OF Salford Unitary Development Plan Review Proposed Modification to the Proposals Map

- Address: Wildlife Corridor (Land at Liverpool Road / Cadishead Way)
- Policy: Policy EN7D
- Modification: Delete land bounded by Liverpool Road, Cadishead Way and draft housing allocation H9/30 from the Wildlife Corridor Key Area of Search

MOD 542

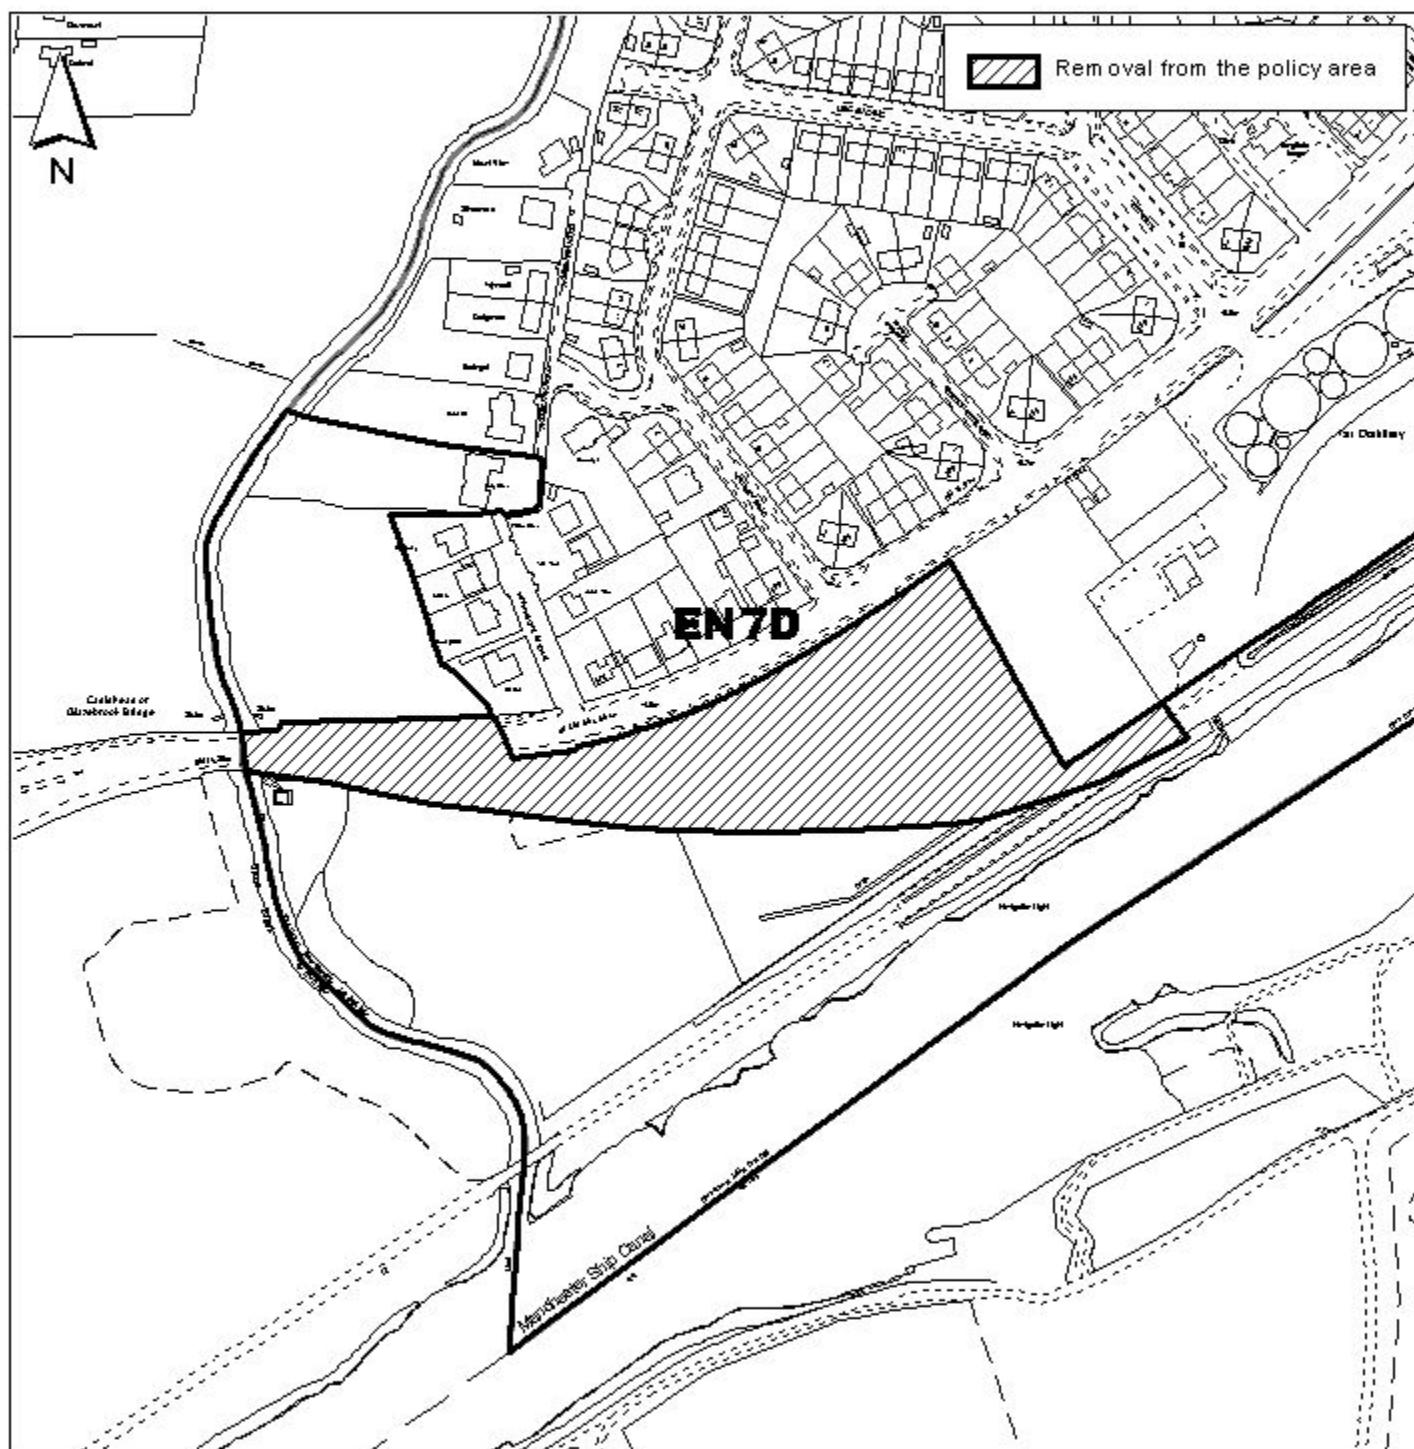

## Salford City Council

Development Planning Section,  
Development Services,  
Salford Civic Centre, Chorley Rd,  
Swinton, Salford M27 6BW.  
[www.salford.gov.uk](http://www.salford.gov.uk)

Job:	Project:	Drawing No.
Drawn:		
Checked:		
Scale: 1:3000	Title:	Revision
Date: Oct 2005		
Filename: UDP MOD		

\*Reproduced from the Ordnance Survey mapping with the permission of the Controller of Her Majesty's Stationery Office © Crown copyright.


Unauthorised reproduction infringes Crown copyright and may lead to prosecution or civil proceedings. Salford City Council. Licence No. 100019737. 2004.

udp modifications to proposals map.spr

# CITY OF SALFORD UNITARY DEVELOPMENT PLAN REVIEW PROPOSED MODIFICATION TO THE PROPOSALS MAP

- Address: World Heritage Site
- Policy: Policy CH1
- Modification: Delete the policy from the proposals map

MOD 543

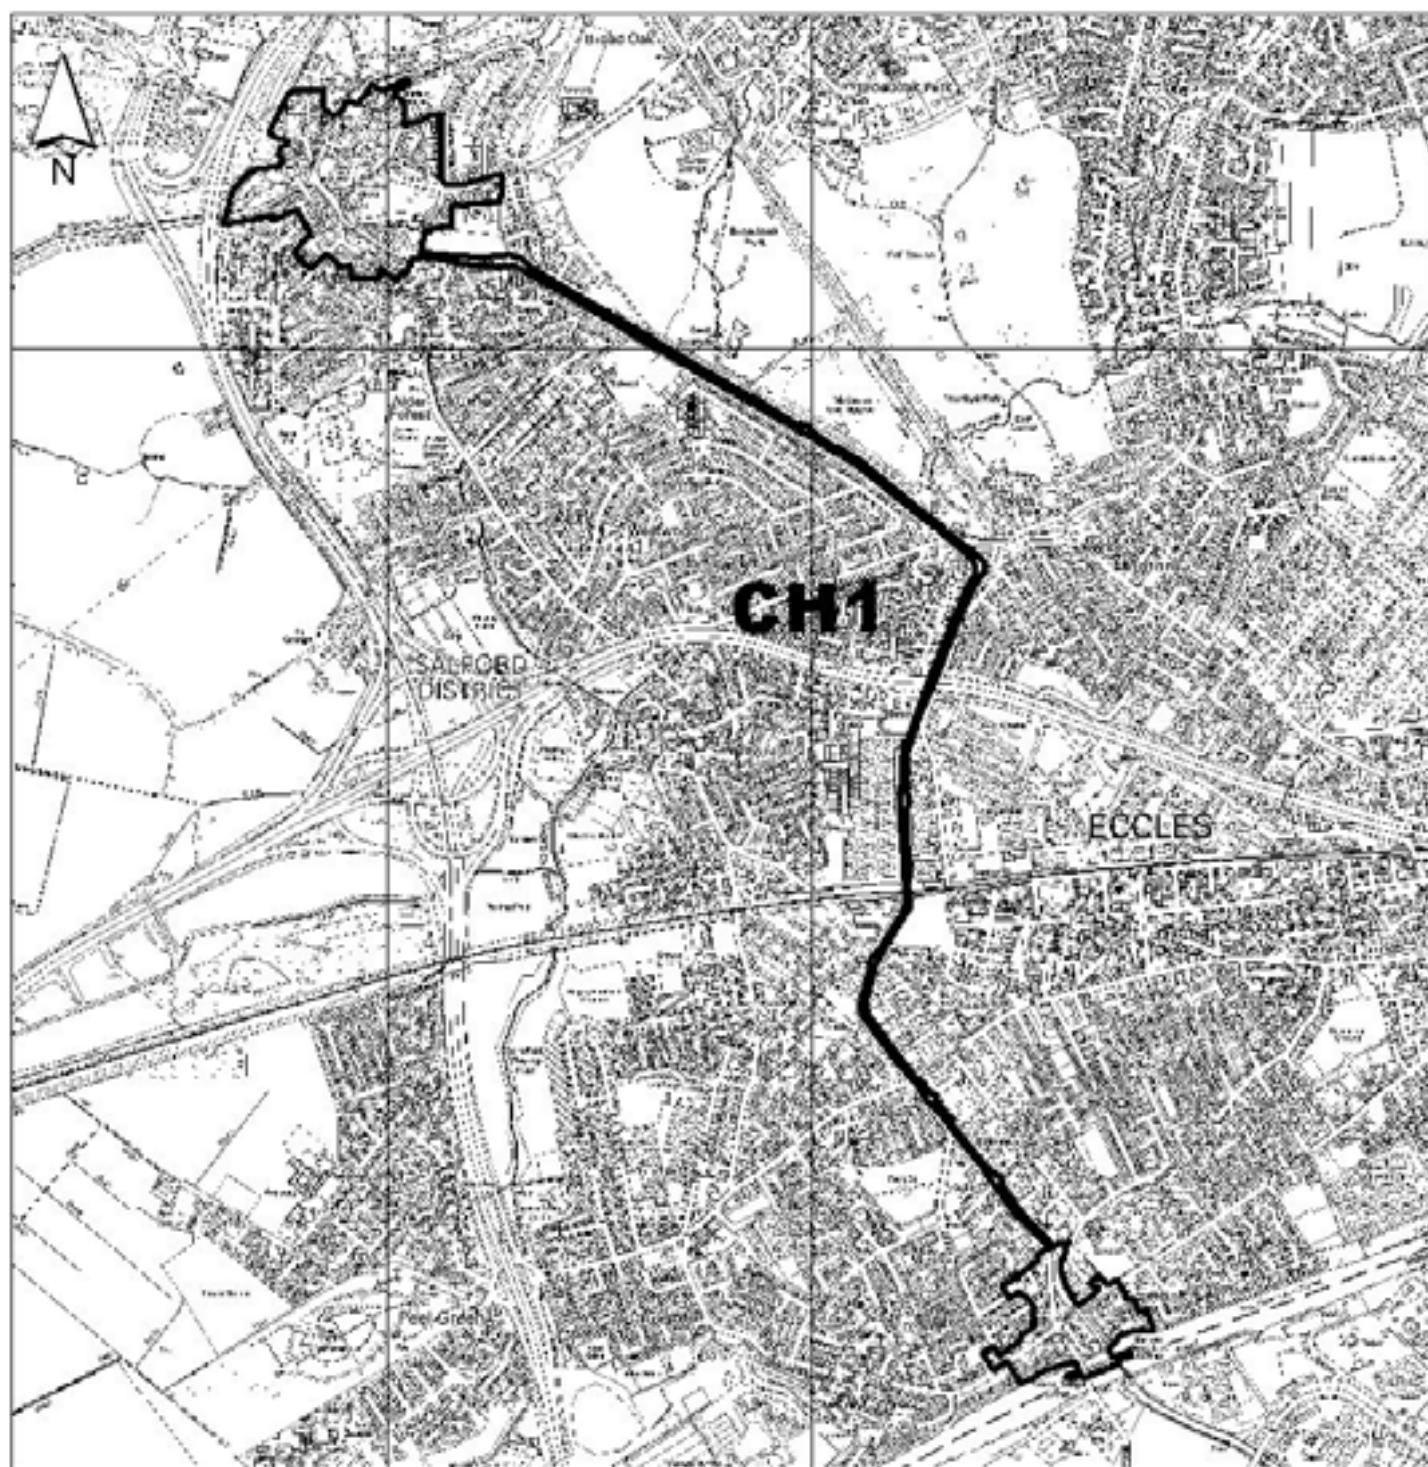

Salford City Council


Development Planning Section,  
Development Services,  
Salford Civic Centre, Chorley Rd,  
Swinton, Salford M27 5BW.  
[www.salford.gov.uk](http://www.salford.gov.uk)

Job:	Project:	Drawing No.
Drawn:		
Checked:		
Scale: 1:18000	Title:	
Date: Oct 2005		Revision:
Filename: UDPMOD		

# CITY OF SALFORD UNITARY DEVELOPMENT PLAN REVIEW PROPOSED MODIFICATION TO THE PROPOSALS MAP

MOD 544

- Address: Cliff Conservation Area
- Policy: Policy CH5/5
- Modification: Amend the boundary of the Cliff Conservation Area to include land east of Grecian Street North and south of Grecian Street North Primary School

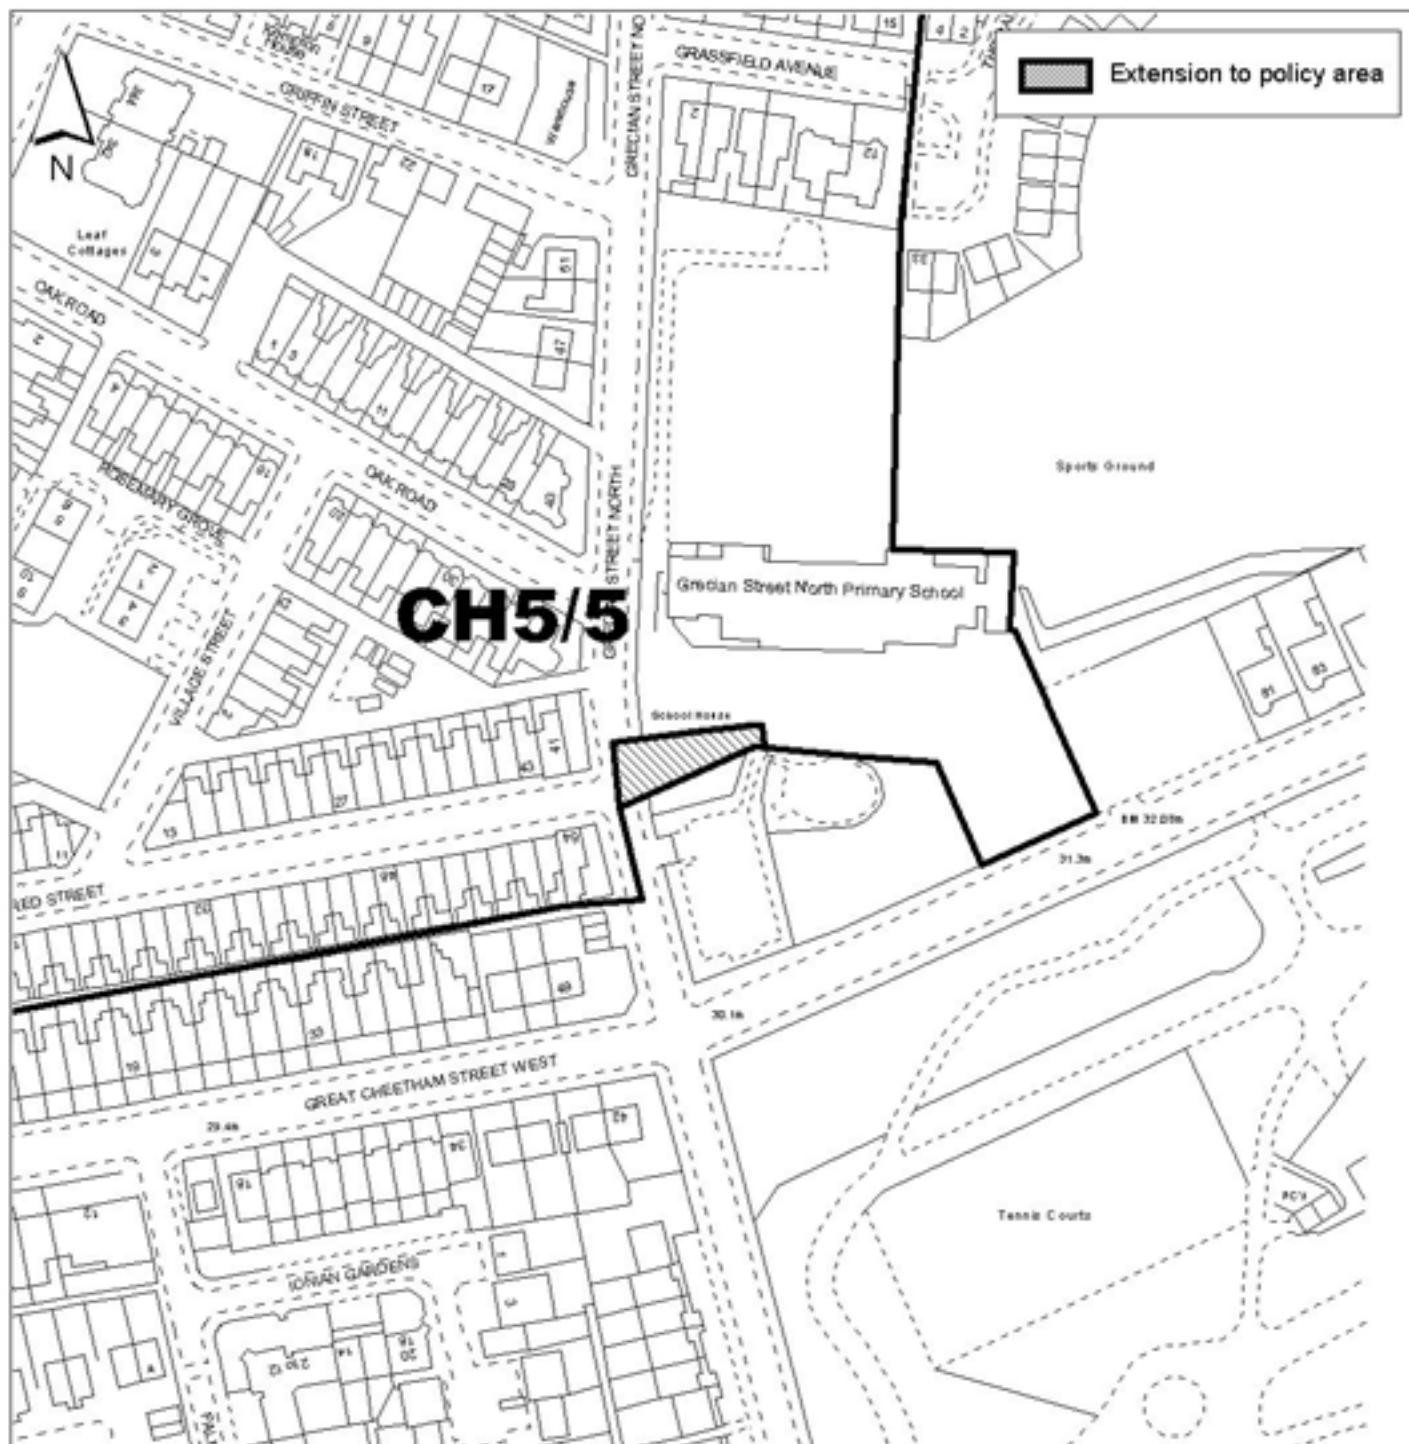

Salford City Council

Development Planning Section,  
Development Services,  
Salford Civic Centre, Chorley Rd,  
Swinton, Salford M27 5BW.  
[www.salford.gov.uk](http://www.salford.gov.uk)

Job:	Project:	Drawing No.
Drawn:		
Checked:		
Scale: 1:1500		
Date: Oct 2005	Title:	Revision
Filename: UDPMOD		


'Reproduced from the Ordnance Survey mapping with the permission of the Controller of Her Majesty's Stationery Office © Crown copyright.  
Unauthorised reproduction infringes Crown copyright and may lead to prosecution or civil proceedings. Salford City Council. Licence No. 100019737. 2004.'

udp modifications to proposals map.apr

# CITY OF SALFORD UNITARY DEVELOPMENT PLAN REVIEW PROPOSED MODIFICATION TO THE PROPOSALS MAP

- Address: Blackleach Country Park
- Policy: Policy R4/1
- Modification: Amend the boundary of Blackleach Country Park Key Recreation Area to include land north of Hill Top Road and east of Bolton Road

MOD 545

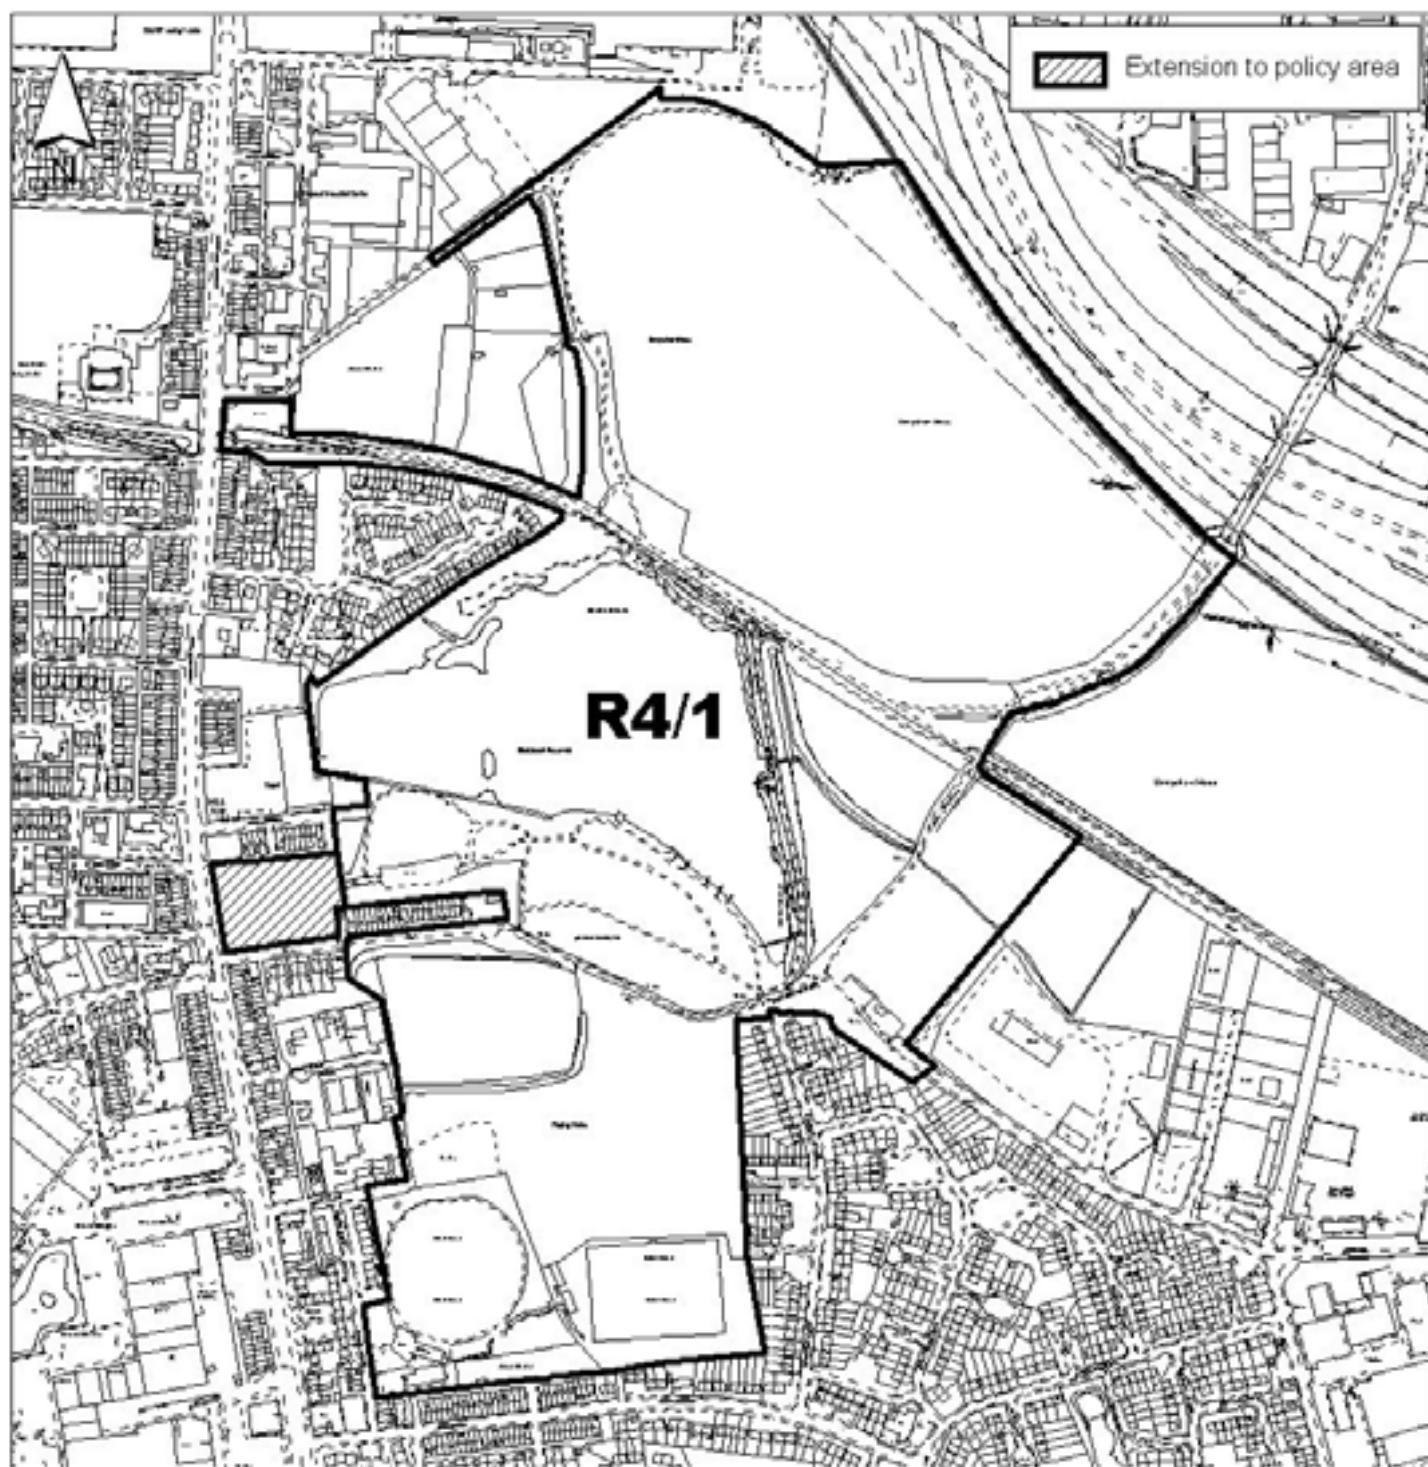

Salford City Council

Development Planning Section,  
Development Services,  
Salford Civic Centre, Chorley Rd,  
Swinton, Salford M27 5BW.  
[www.salford.gov.uk](http://www.salford.gov.uk)

Job:	Project:	Drawing No.:
Drawn:		
Checked:		
Scale: 1:6000	Title:	
Date: Oct 2005		Revision:
Filename: UDPMOD		

Reproduced from the Ordnance Survey mapping with the permission of the Controller of Her Majesty's Stationery Office © Crown copyright.  
Unauthorised reproduction infringes Crown copyright and may lead to prosecution or civil proceedings. Salford City Council Licence No. 100019737. 2004.

Map modifications to proposals map ap1

# CITY OF SALFORD UNITARY DEVELOPMENT PLAN REVIEW PROPOSED MODIFICATION TO THE PROPOSALS MAP

- Address: Bradford Road to Monton Road
- Policy: Policy R5
- Modification: Additional Existing Strategic Recreation Route

MOD 546



Salford City Council

Development Planning Section,  
Development Services,  
Salford Civic Centre, Chorley Rd,  
Swinton, Salford M27 6BW,  
[www.salford.gov.uk](http://www.salford.gov.uk)

Job:	Project:	Drawing No.
Drawn:		
Checked:		
Scale: 1:4500	Title:	Revision
Date: Oct 2005		
Filename: UDPMOD		


\*Reproduced from the Ordnance Survey mapping with the permission of the Controller of Her Majesty's Stationery Office © Crown copyright.  
Unauthorised reproduction infringes Crown copyright and may lead to prosecution or civil proceedings. Salford City Council. Licence No. 100019737. 2004.

UDP modification to proposals map

# CITY OF SALFORD UNITARY DEVELOPMENT PLAN REVIEW PROPOSED MODIFICATION TO THE PROPOSALS MAP

- Address: Duncan Mathieson Playing Fields and adjoining land
- Policy: Policy R6/3
- Modification: Amend allocation from 'land adjoining Duncan Mathieson Playing Fields' to 'The Duncan Mathieson Playing Fields and adjoining land'.

MOD 547

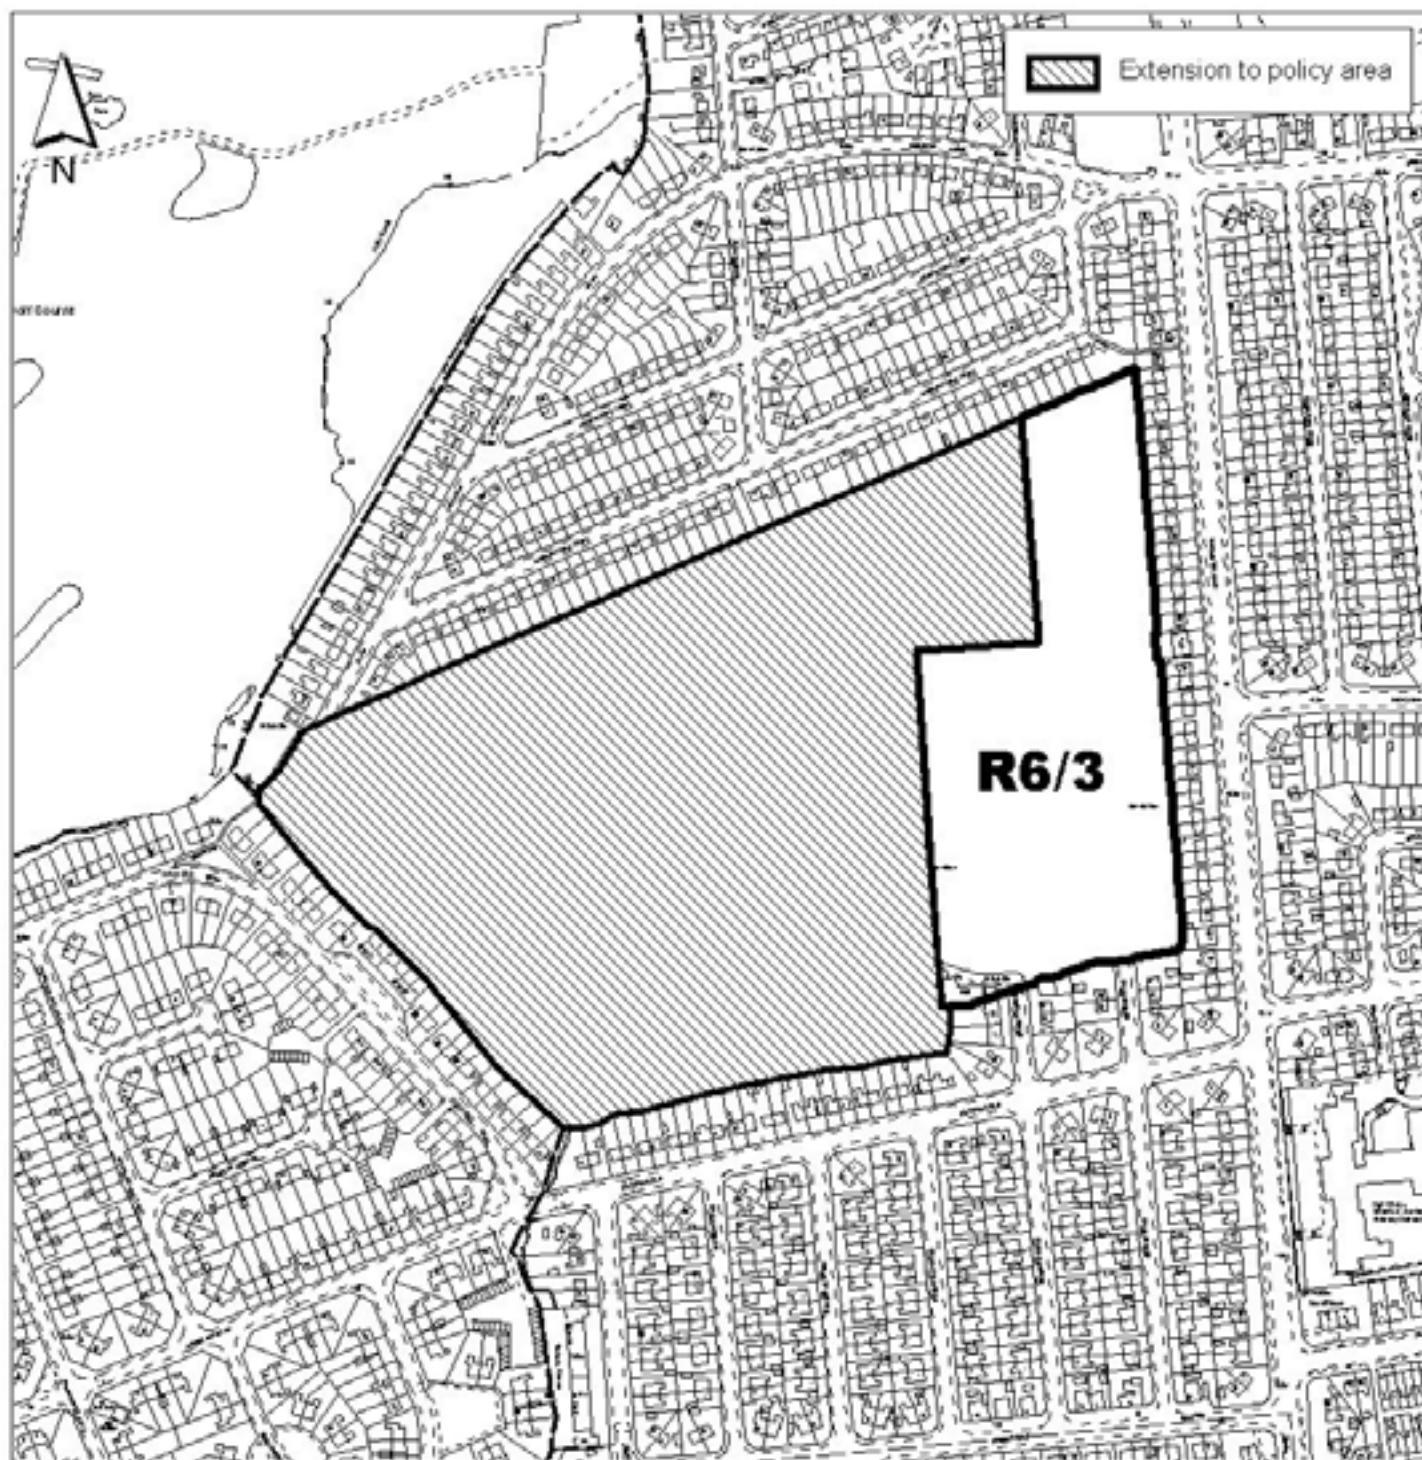

Salford City Council

Development Planning Section,  
Development Services,  
Salford Civic Centre, Chorley Rd,  
Swinton, Salford M27 6BW,  
[www.salford.gov.uk](http://www.salford.gov.uk)

Job:	Project:	Drawing No.
Drawn:		
Checked:		
Scale: 1:4000		
Date: Oct 2005		
Filename: UDPMOD		
	Title:	Revision


\*Reproduced from the Ordnance Survey mapping with the permission of the Controller of Her Majesty's Stationery Office © Crown copyright.  
Unauthorised reproduction infringes Crown copyright and may lead to prosecution or civil proceedings. Salford City Council. Licence No. 100019737. 2004.

UDP modification to proposals map

# CITY OF SALFORD UNITARY DEVELOPMENT PLAN REVIEW PROPOSED MODIFICATION TO THE PROPOSALS MAP

- Address: Alder Forest, Winton
- Policy: Policy R6/16
- Modification: Delete land to the north west of the footpath leading to Granary Lane and to the rear of residential gardens on Rycroft Lane from the policy

MOD 548

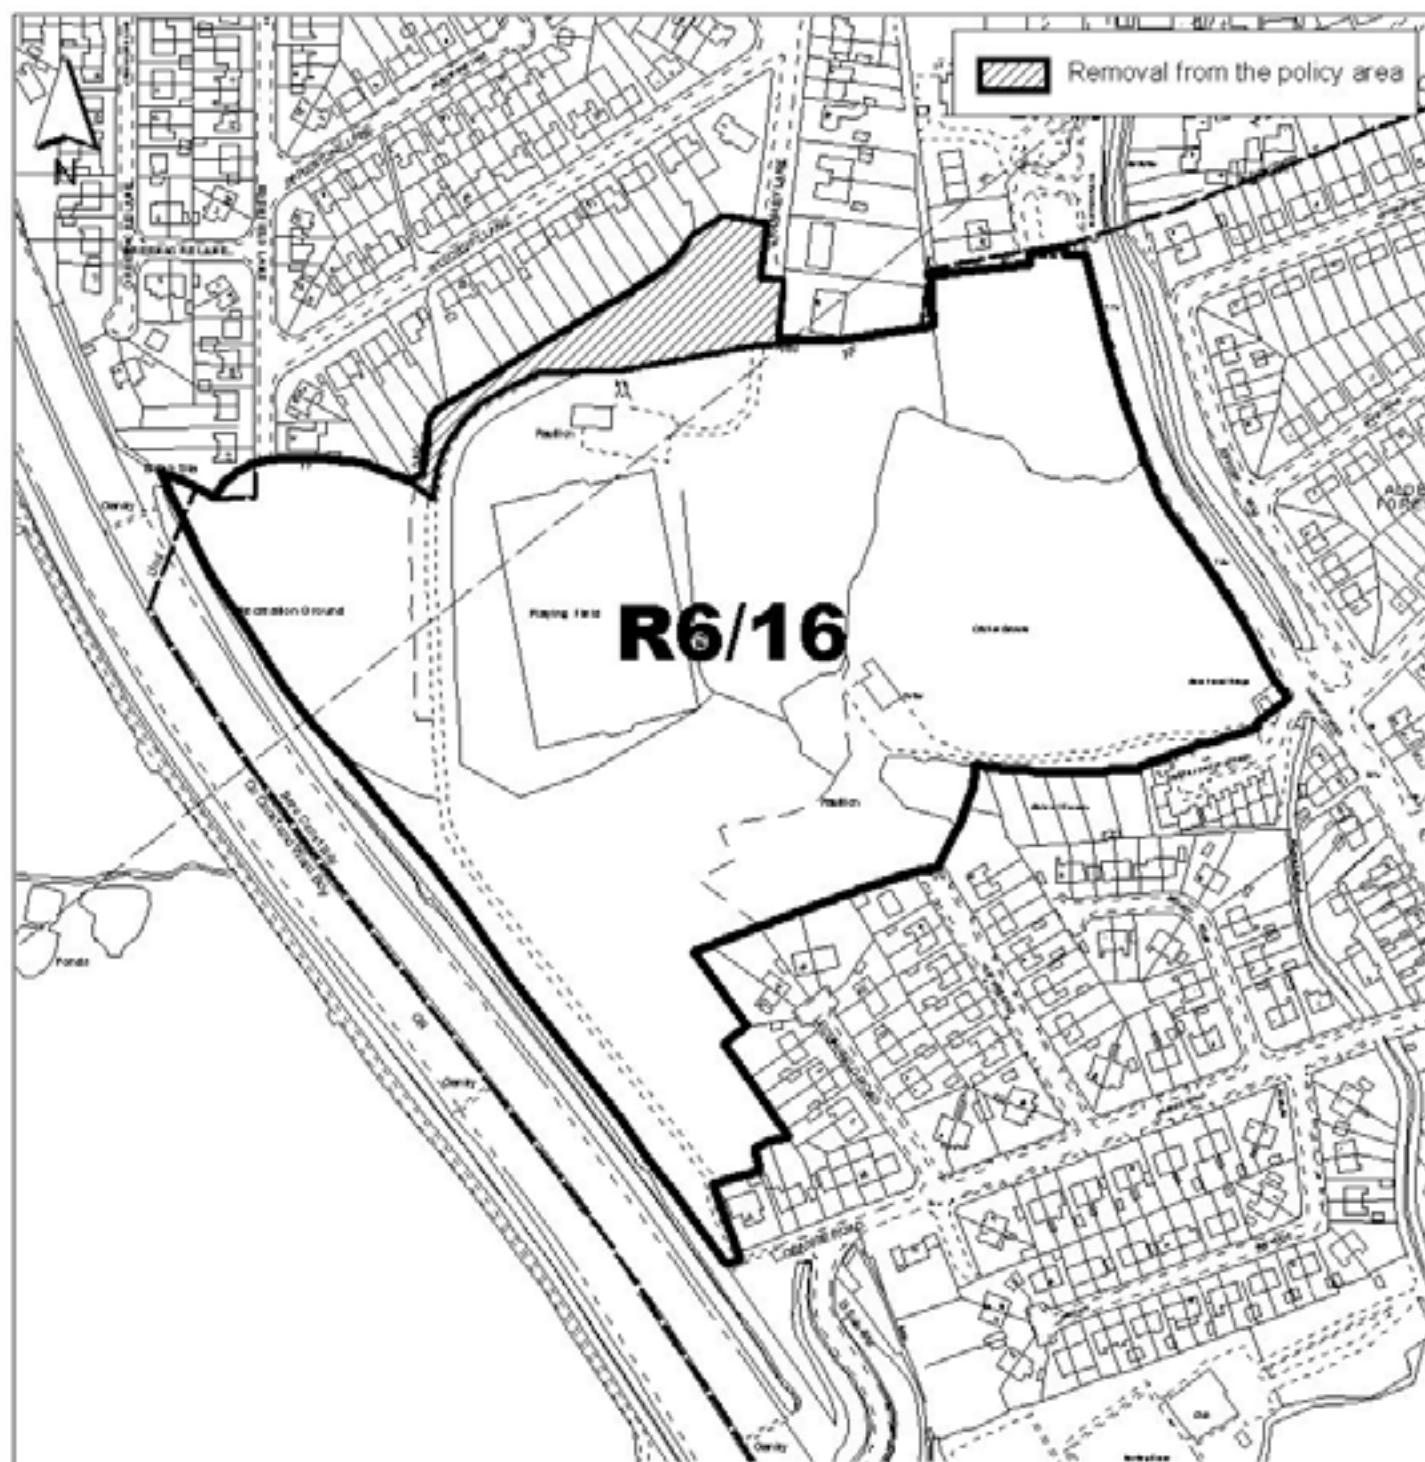


Salford City Council

Development Planning Section,  
Development Services,  
Salford Civic Centre, Chorley Rd,  
Swinton, Salford M27 6BW,  
[www.salford.gov.uk](http://www.salford.gov.uk)

Job:	Project:	Drawing No.
Drawn:		
Checked:		
Scale: 1:3200	Title:	Revision
Date: Oct 2005		
Filename: UDPMOD		

CITY OF Salford Unitary Development Plan Review  
Proposed Modification to the Proposals Map

MOD 549

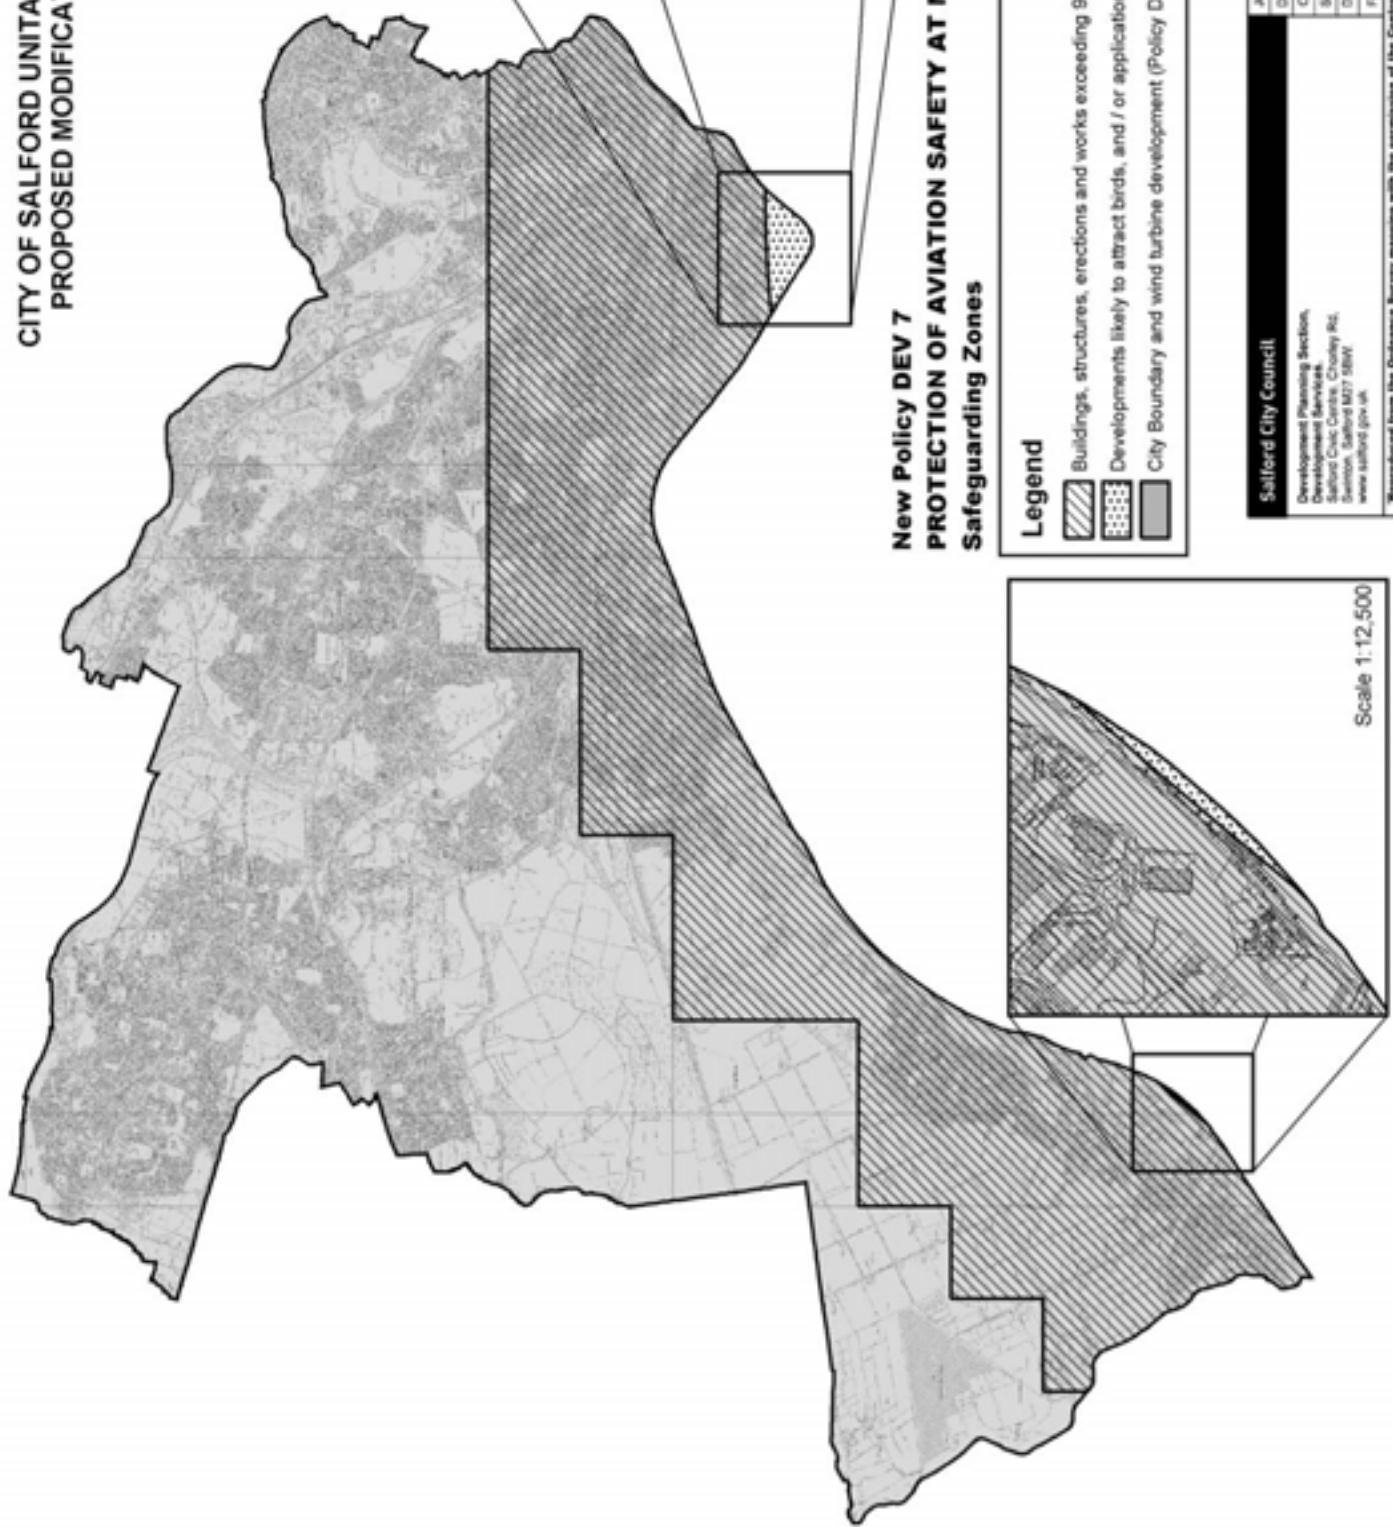

Salford City Council


Development Planning Section,  
Development Services,  
Salford Civic Centre, Chorley Rd,  
Salford M7 1SW  
www.salford.gov.uk

Job No.	Project	Drawing No.
Open		
Checked		
Scale	1:54,302	Ref:
Date	Oct 2005	
Editor		

Reproduced from the Ordnance Survey mapping with the permission of the Controller of Her Majesty's Stationery Office & Crown copyright.  
Unauthorised reproduction unlicensed copying is illegal proceedings. Salford City Council, Lancashire, M7 1SW, 2004.

CITY OF Salford Unitary Development Plan Review  
Proposed Modification to be Inserted into the Written Statement as Appendix 4

MOD 550

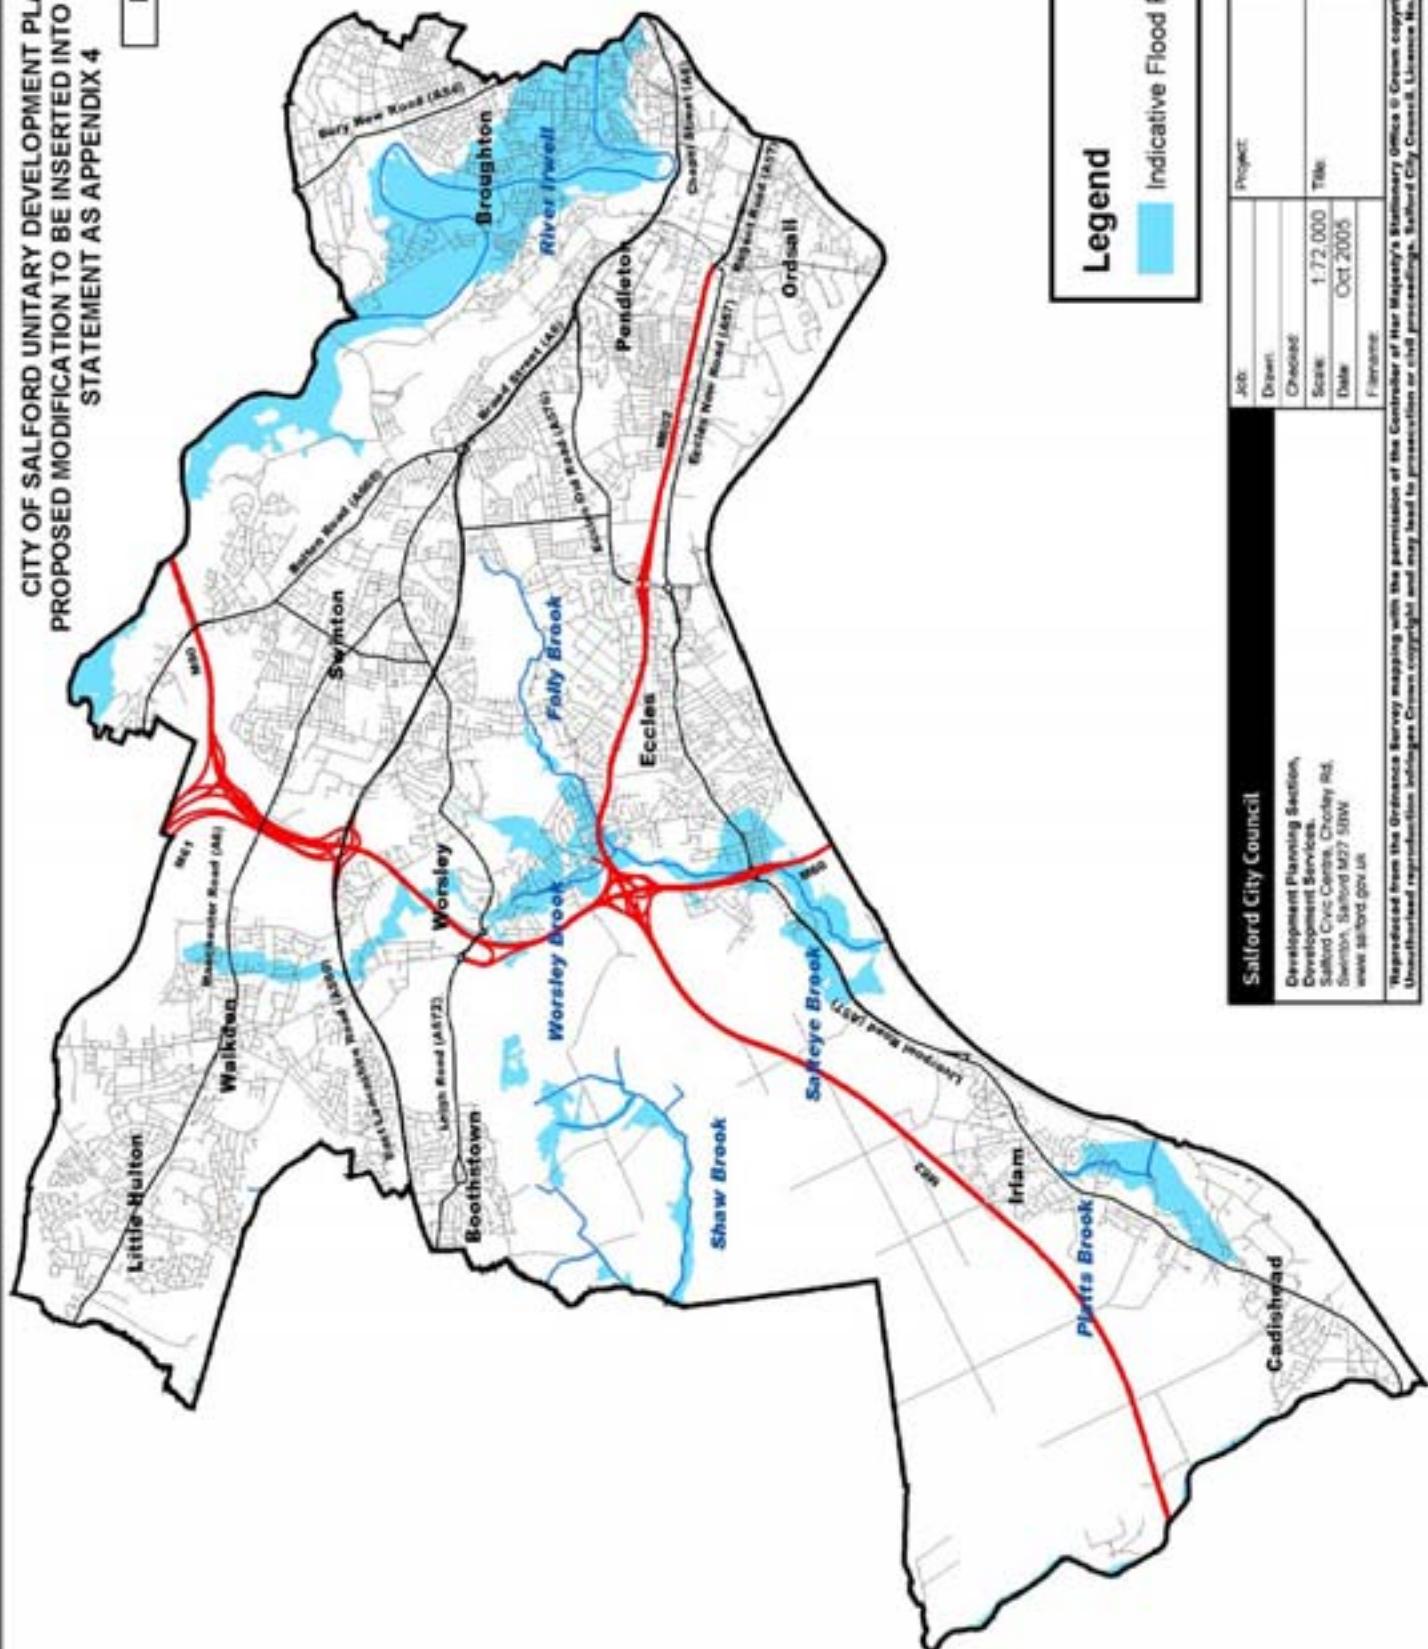

**Legend**

Indicative Flood Plains (EN16)

Job No:	Project:	Drawing No:
Drawn:		
Checked:		
Scale:	1:72,000	Title:
Date:	Oct 2005	Revision:
File name:		

Salford City Council  
Development Planning Section,  
Development Services,  
Salford Civic Centre, Crookley Rd,  
Salford M27 3NN  
[www.salford.gov.uk](http://www.salford.gov.uk)

Reproduced from the Ordnance Survey mapping with the permission of the Controller of Her Majesty's Stationery Office © Crown copyright.  
Unauthorised reproduction infringes Crown copyright and may lead to prosecution or civil proceedings. Salford City Council. Licence No. 100001917397. 2004.