


CITY OF SALFORD UNITARY DEVELOPMENT PLAN REVIEW PROPOSED MODIFICATION TO SPATIAL FRAMEWORK DIAGRAM AS SHOWN ON THE PROPOSALS MAP

MOD 505

- Address: Western Gateway
- Policy: Chapter 3
- Modification: Amend the boundary of the Western Gateway as shown on the Spatial Framework diagram, to include the existing built up part of Barton Aerodrome on the A57 frontage

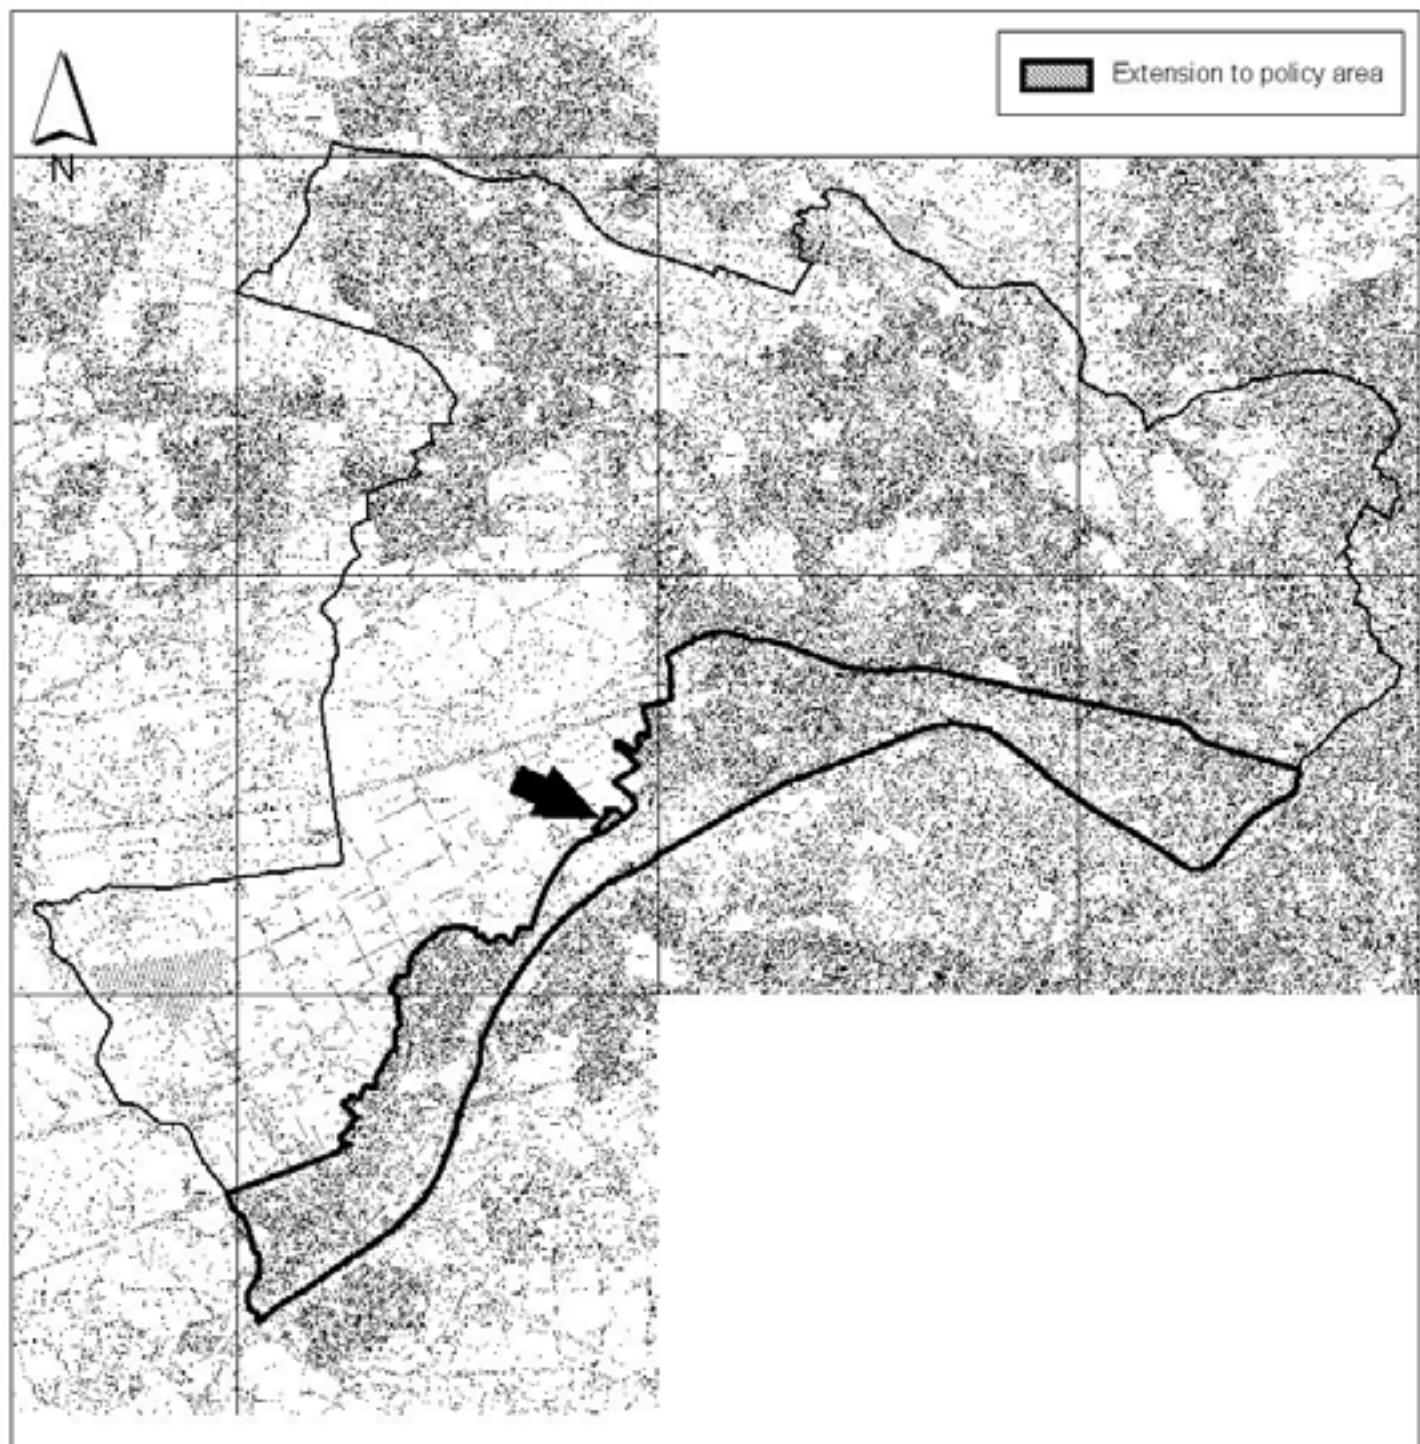

Salford City Council

Development Planning Section,
Development Services,
Salford Civic Centre, Chorley Rd,
Swinton, Salford M27 6BW.
www.salford.gov.uk

Job:	Project:	Drawing No.
Drawn:		
Checked:		
Scale: 1:90000	Title:	Revision
Date: Oct 2005		
Filename: UDPMOD		


*Reproduced from the Ordnance Survey mapping with the permission of the Controller of Her Majesty's Stationery Office © Crown copyright.
Unauthorised reproduction infringes Crown copyright and may lead to prosecution or civil proceedings. Salford City Council. Licence No. 100019737. 2004.

udp_modification_to_proposal_map.apm

CITY OF SALFORD UNITARY DEVELOPMENT PLAN REVIEW PROPOSED MODIFICATION TO THE PROPOSALS MAP

- Address: Wharton Lane, Little Hulton
- Policy: Policy MX3/2
- Modification: Delete the policy from the Proposals Map

MOD 506

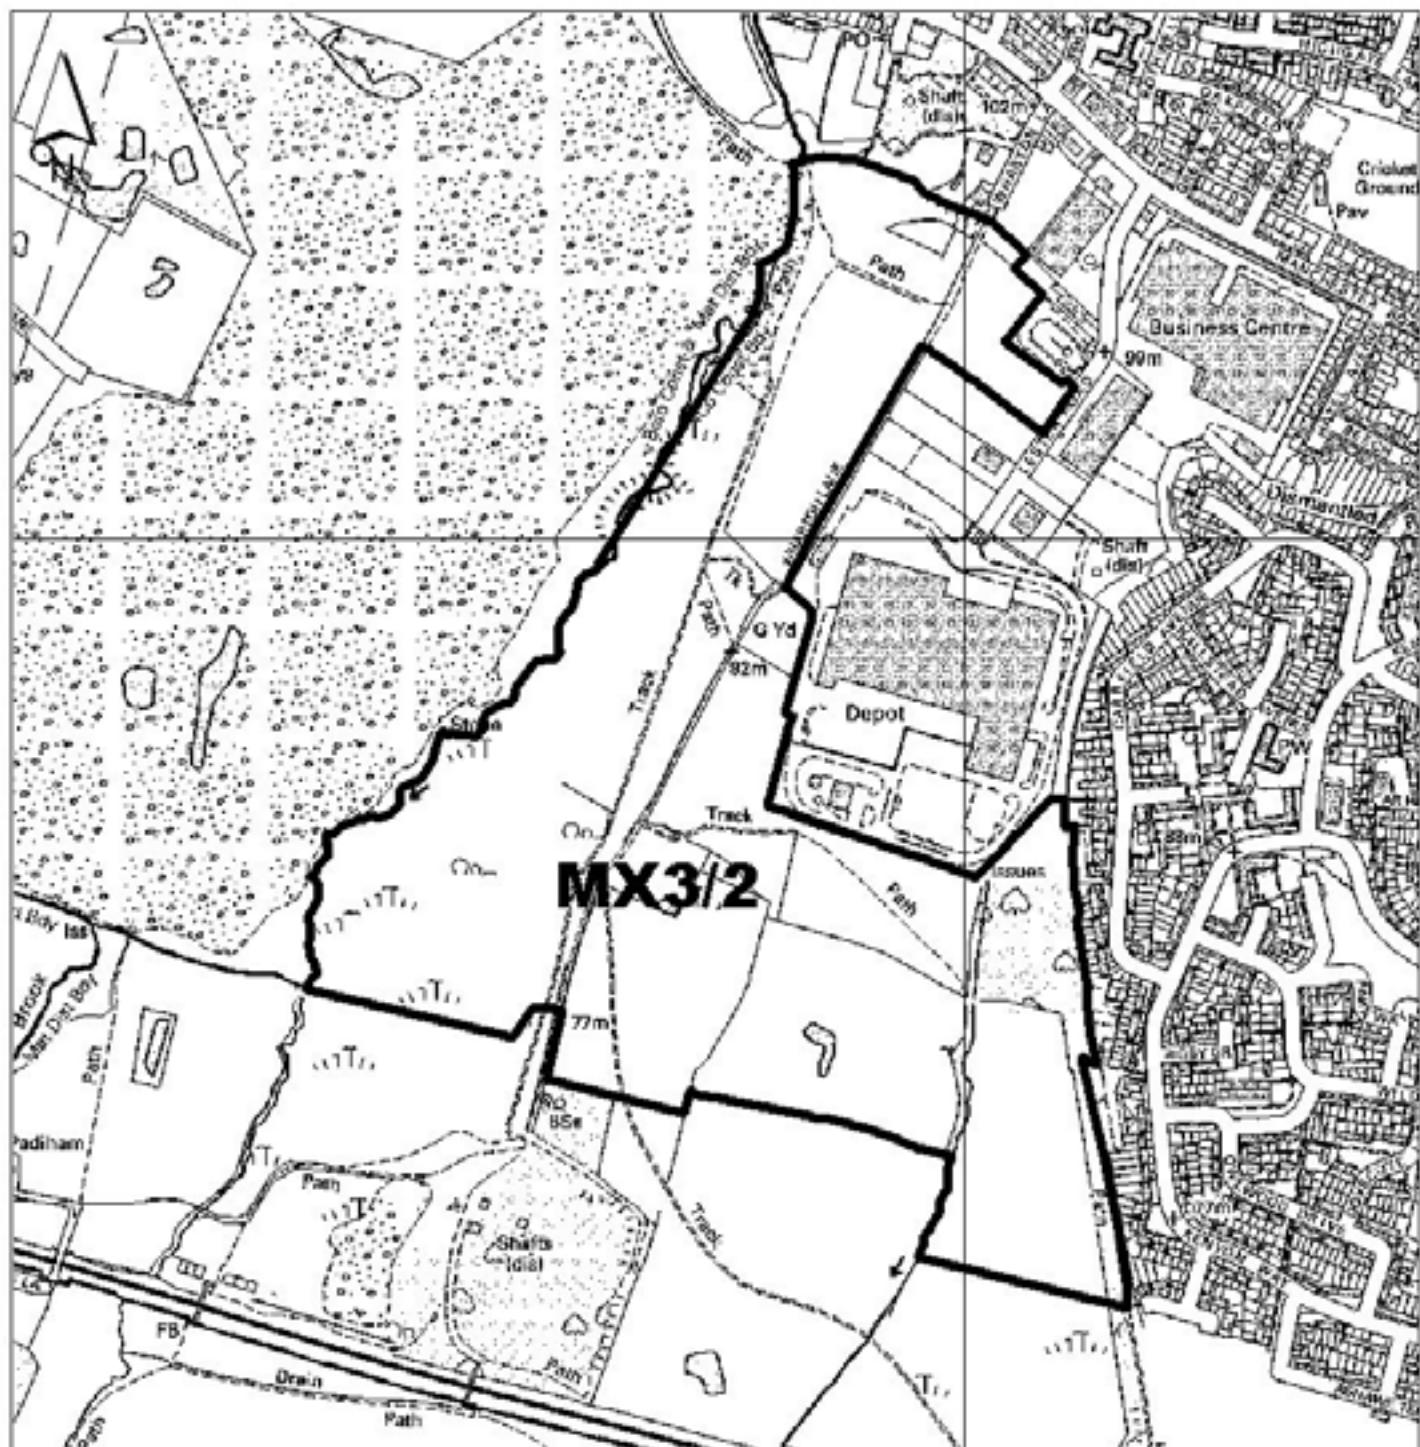

Salford City Council

Development Planning Section,
Development Services,
Salford Civic Centre, Chorley Rd,
Swinton, Salford M27 6BW.
www.salford.gov.uk

Job:	Project:	Drawing No.
Drawn:		
Checked:		
Scale:	1:7000	
Date:	Oct 2005	
Filename:	UDPMOD	
Title:		Revision


*Reproduced from the Ordnance Survey mapping with the permission of the Controller of Her Majesty's Stationery Office © Crown copyright.
Unauthorised reproduction infringes Crown copyright and may lead to prosecution or civil proceedings. Salford City Council. Licence No. 100019737. 2006.

udp.modification.to.proposal.map.apr

CITY OF SALFORD UNITARY DEVELOPMENT PLAN REVIEW PROPOSED MODIFICATION TO THE PROPOSALS MAP

- Address: Former Swinton Sewage Treatment Works, Swinton South
- Policy: Policy MX3/4
- Modification: Delete the policy from the Proposals Map

MOD 507

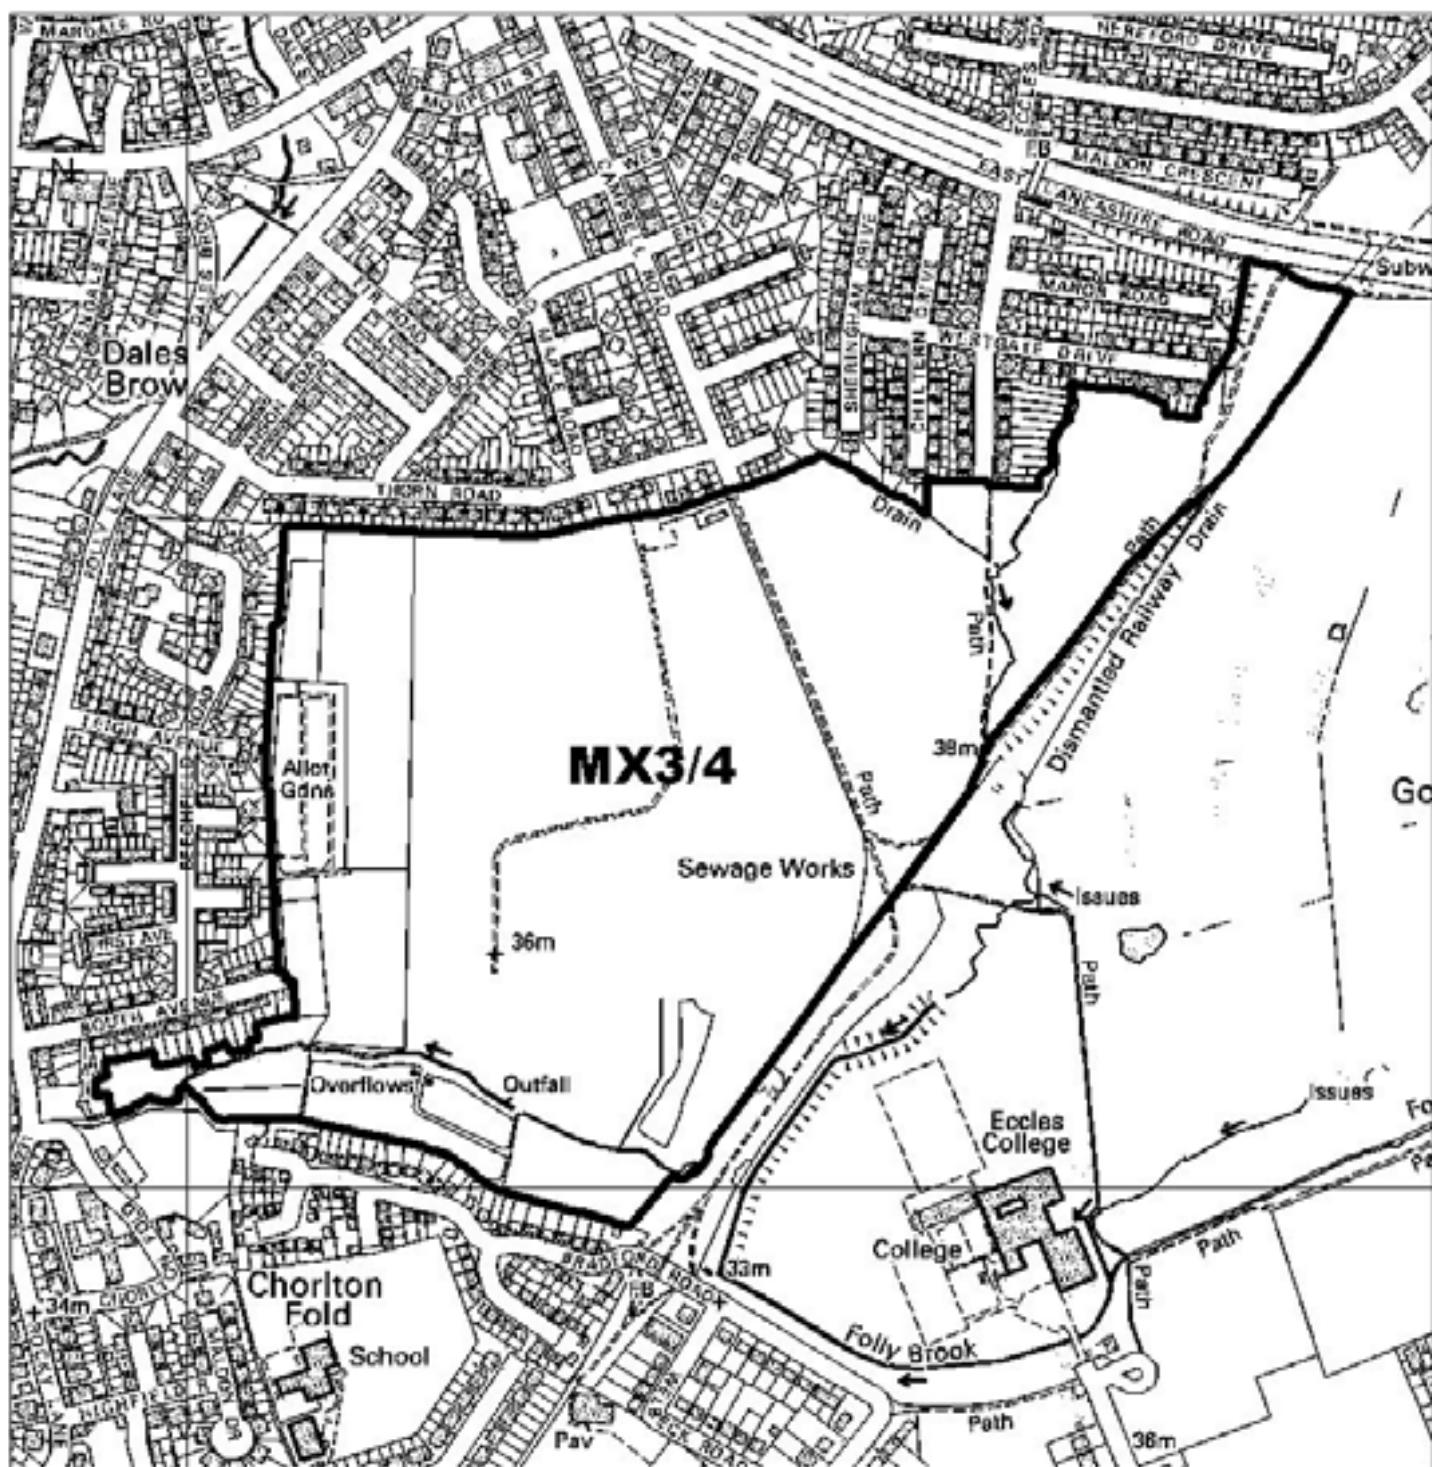

Salford City Council


Development Planning Section,
Development Services,
Salford Civic Centre, Chorley Rd,
Swinton, Salford M27 5BW.
www.salford.gov.uk

Job:	Project:	Drawing No.:
Drawn:		
Checked:		
Scale: 1:6000	Title:	
Date: Oct 2005		Revision:
Filename: UDPMOD		

CITY OF SALFORD UNITARY DEVELOPMENT PLAN REVIEW PROPOSED MODIFICATION TO THE PROPOSALS MAP

- Address: Land at Barton Lane, Barton
- Policy: Policy H9/1
- Modification: Delete the policy from the Proposals Map

MOD 508

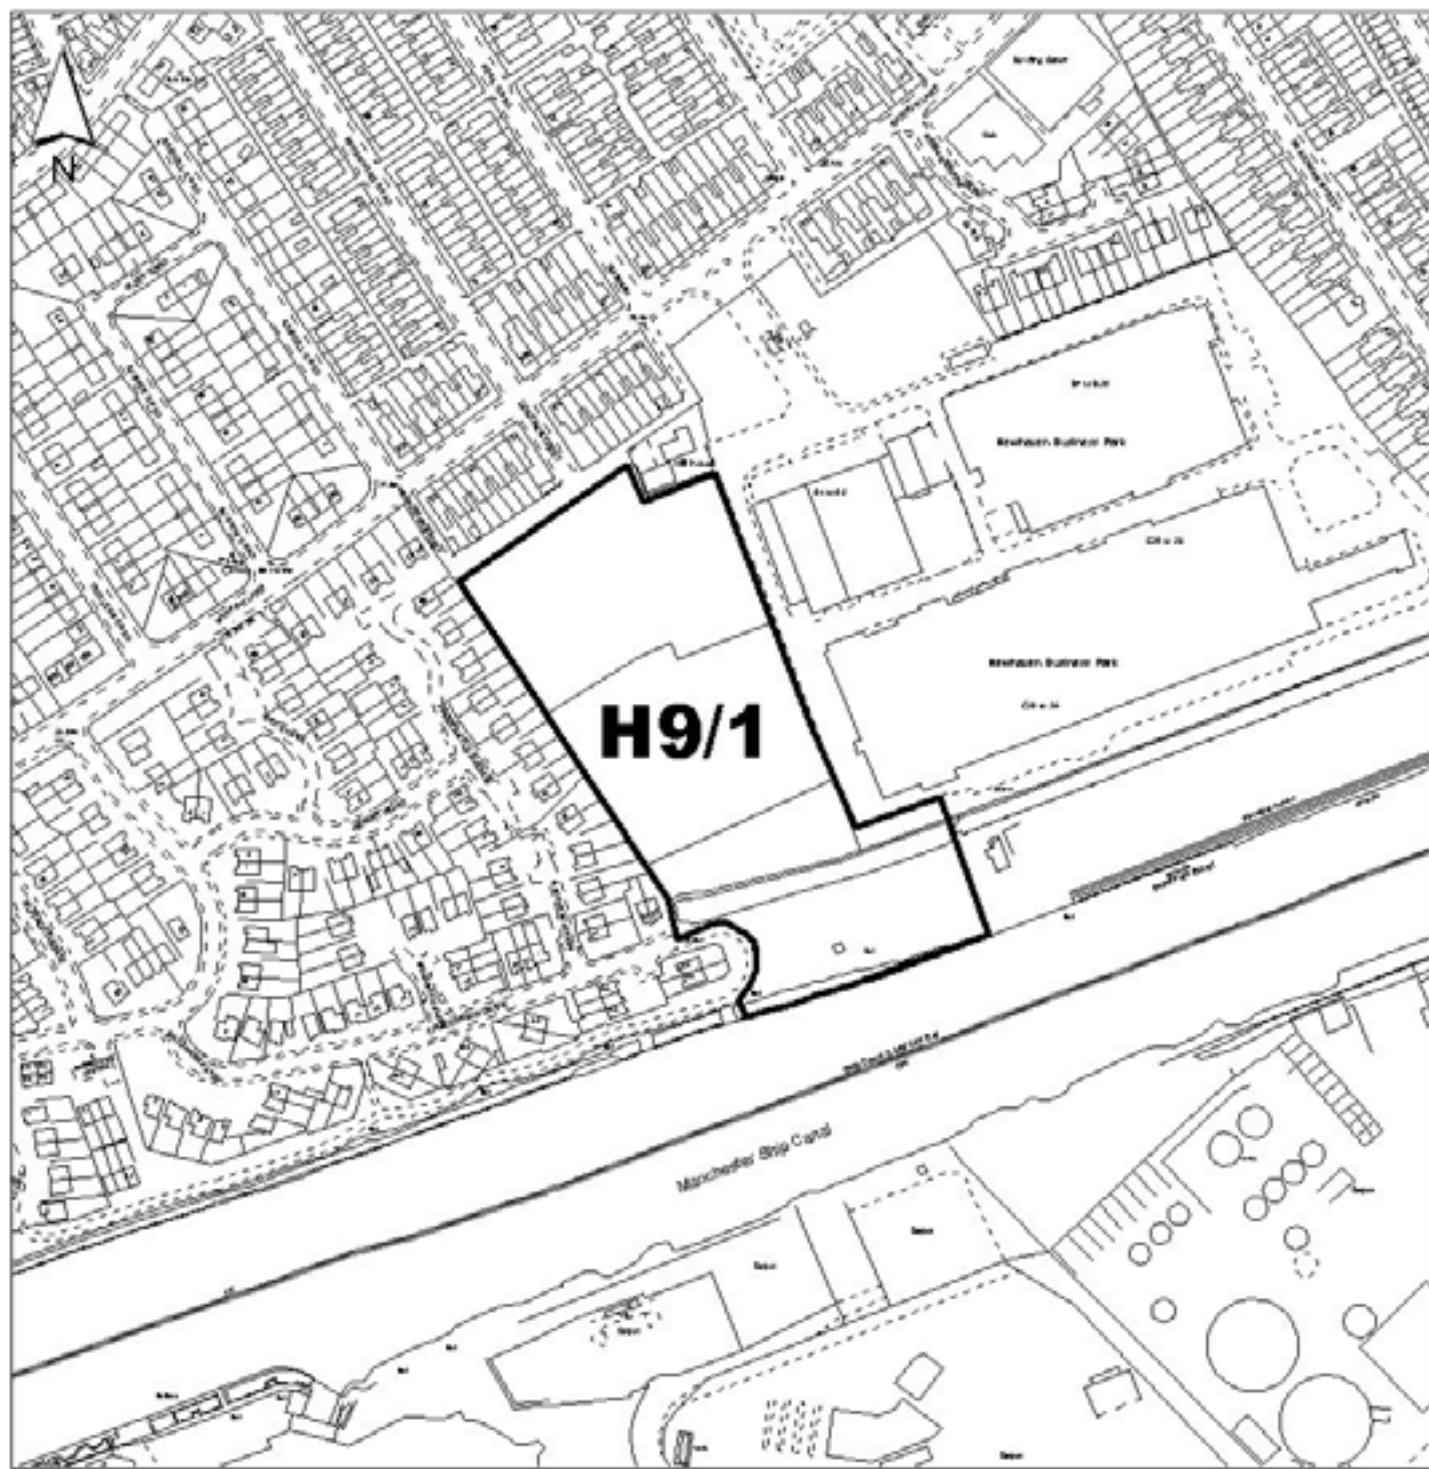

Salford City Council


Development Planning Section,
Development Services,
Salford Civic Centre, Chorley Rd,
Swinton, Salford M27 5BW.
www.salford.gov.uk

Job:	Project:	Drawing No.:
Drawn:		
Checked:		
Scale: 1:3000		
Date: Oct 2005	Title:	Revision:
Filename: UDPMOD		

CITY OF SALFORD UNITARY DEVELOPMENT PLAN REVIEW PROPOSED MODIFICATION TO THE PROPOSALS MAP

- Address: Cambridge Riverside, Blackfriars
- Policy: Policy H9/2
- Modification: Delete the policy from the Proposals Map

MOD 509

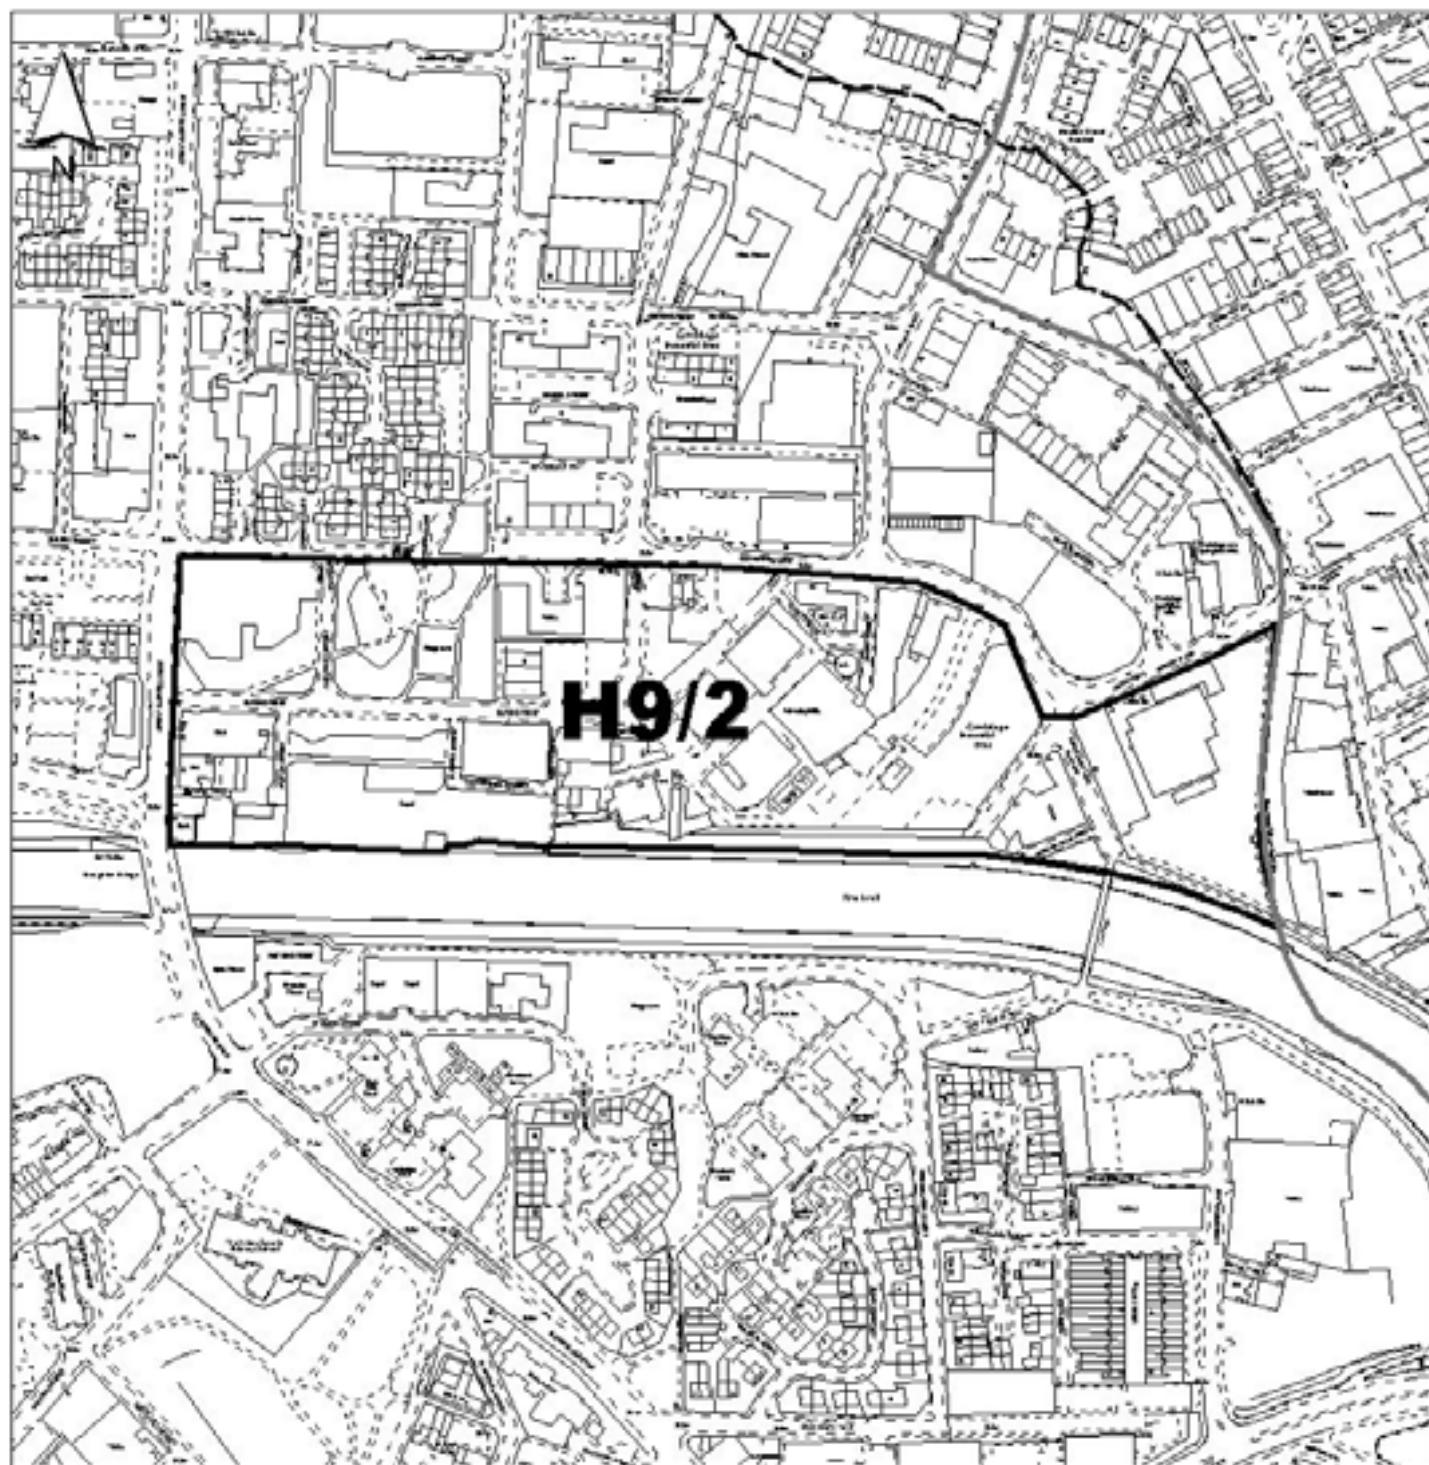

Salford City Council


Development Planning Section,
Development Services,
Salford Civic Centre, Chorley Rd,
Swinton, Salford M27 0BW.
www.salford.gov.uk

Job:	Project:	Drawing No.
Drawn:		
Checked:		
Scale: 1:4000	Title:	
Date: Oct 2005		Revision:
Filename: UDPMOD		

CITY OF SALFORD UNITARY DEVELOPMENT PLAN REVIEW PROPOSED MODIFICATION TO THE PROPOSALS MAP

- Address: Meadow Road, Blackfriars
- Policy: Policy H9/4
- Modification: Delete the policy from the Proposals Map

MOD 510

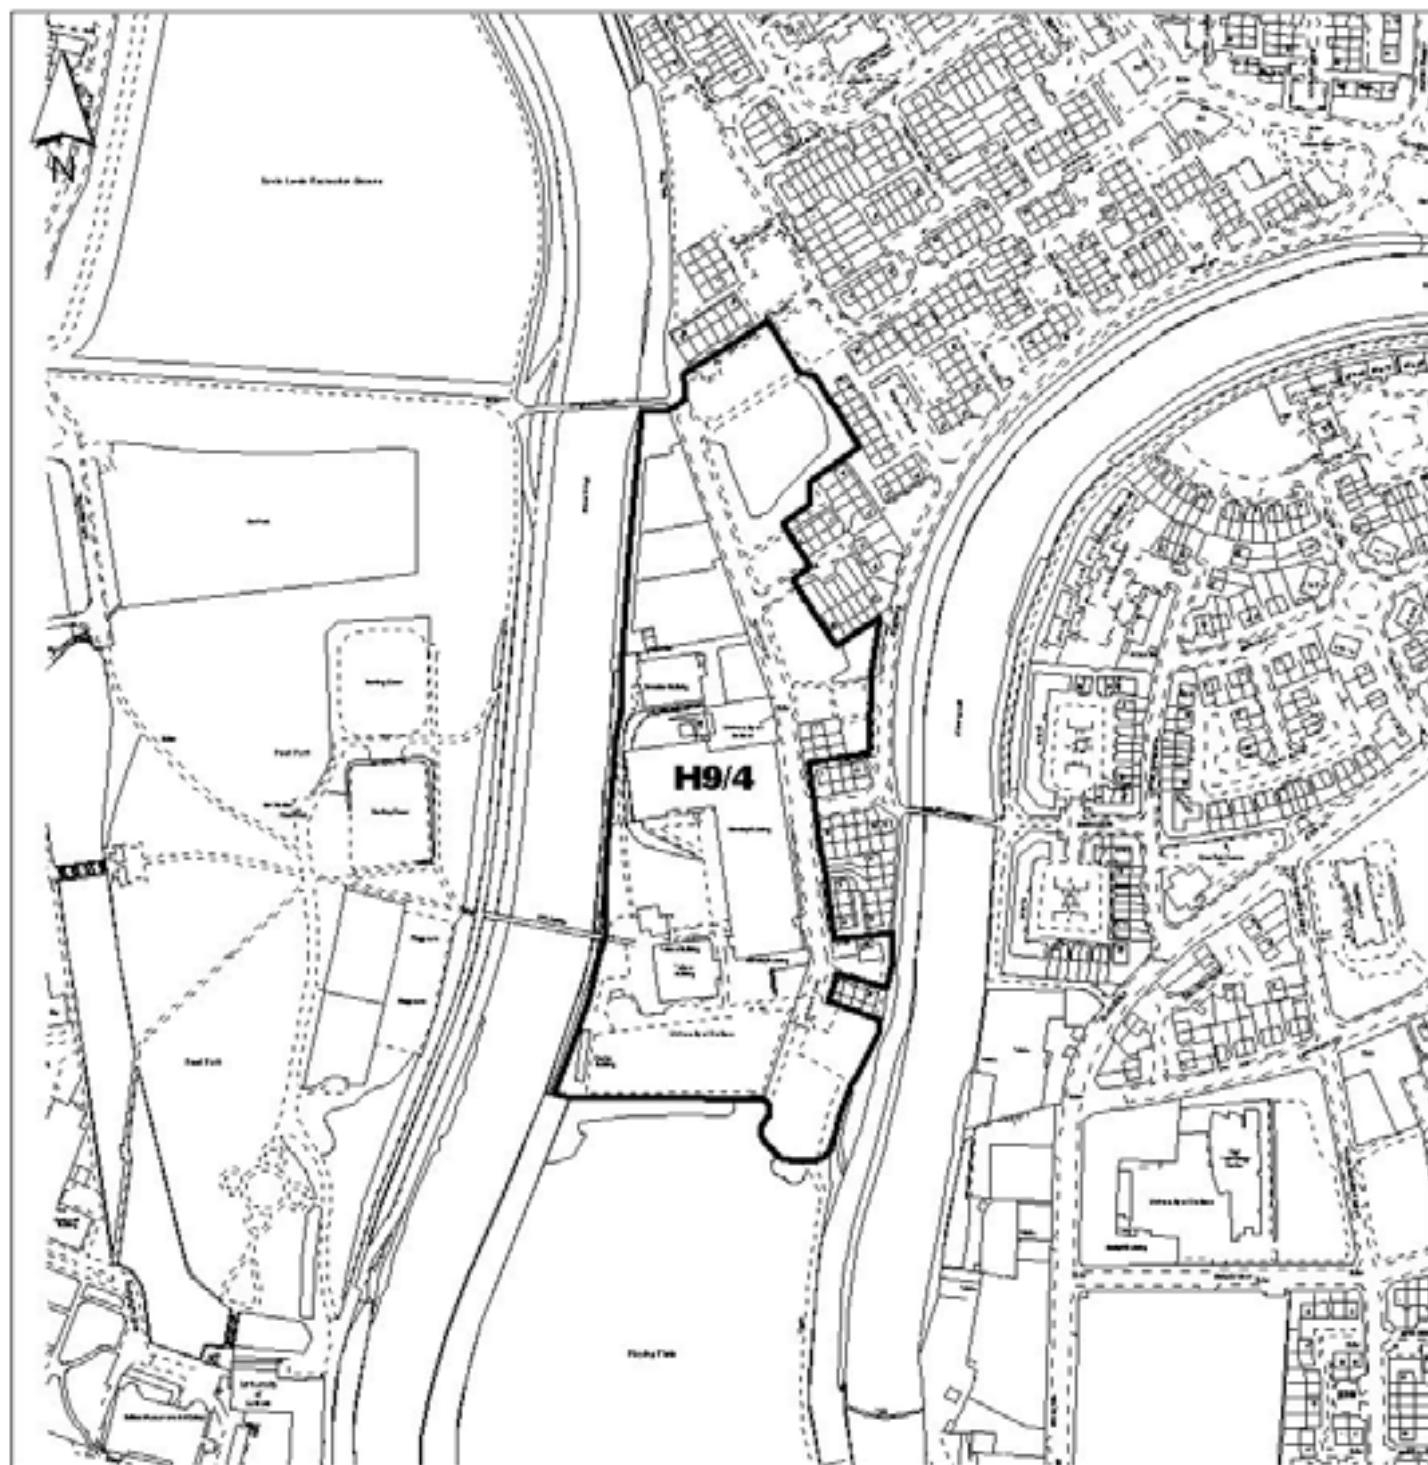

Salford City Council


Development Planning Section,
Development Services,
Salford Civic Centre, Chorley Rd,
Swinton, Salford M27 8BW.
www.salford.gov.uk

Job:	Project:	Drawing No.:
Drawn:		
Checked:		
Scale: 1:4000	Title:	
Date: Oct 2005		Revision:
Filename: UDPMOD		

CITY OF SALFORD UNITARY DEVELOPMENT PLAN REVIEW PROPOSED MODIFICATION TO THE PROPOSALS MAP

- Address: Springfield Lane, Blackfriars
- Policy: Policy H9/5
- Modification: Delete the policy from the Proposals Map

MOD 511

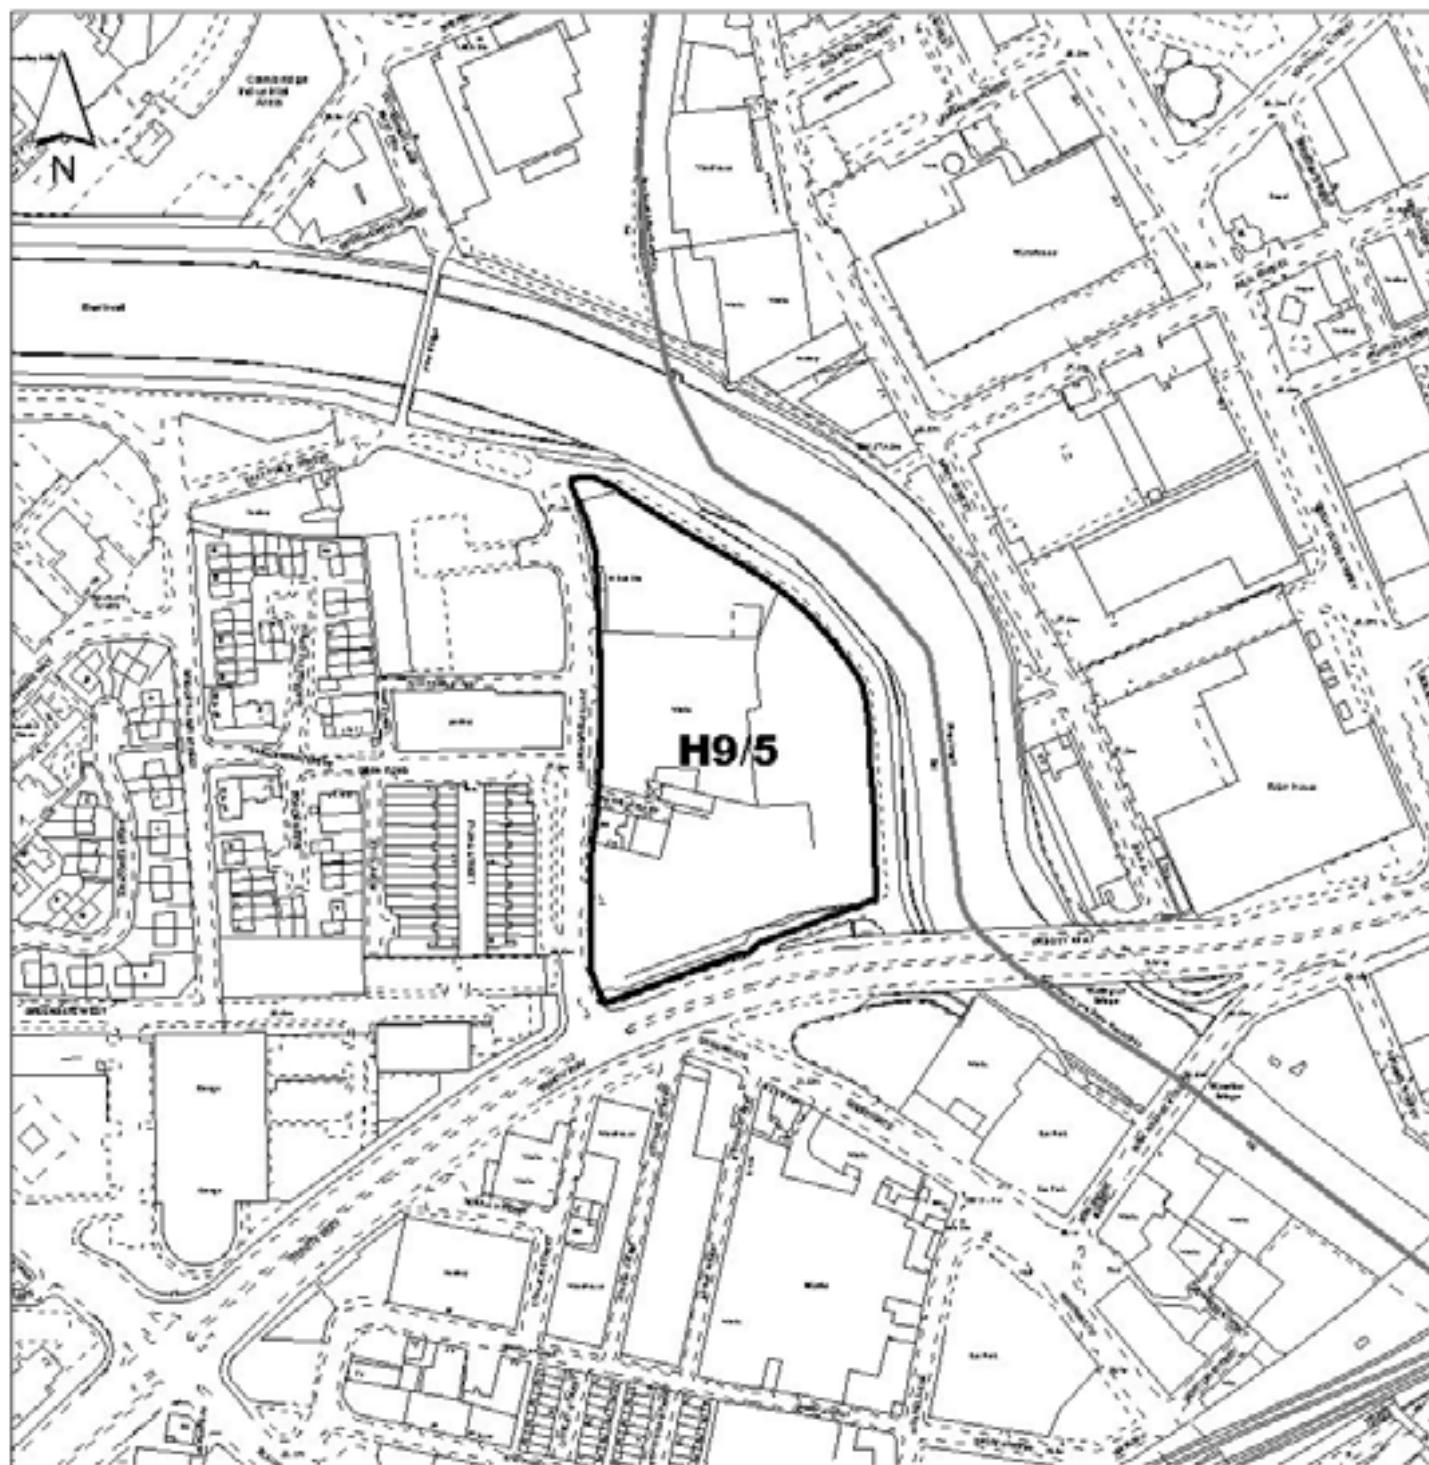

Salford City Council


Development Planning Section,
Development Services,
Salford Civic Centre, Chorley Rd,
Swinton, Salford M27 0BW.
www.salford.gov.uk

Job:	Project:	Drawing No.:
Drawn:		
Checked:		
Scale: 1:3000	Title:	
Date: Oct 2005		Revision:
Filename: UDPMOD		

CITY OF SALFORD UNITARY DEVELOPMENT PLAN REVIEW PROPOSED MODIFICATION TO THE PROPOSALS MAP

- Address: Northumberland Street Playing Fields, Broughton
- Policy: Policy H9/7
- Modification: Delete the policy from the Proposals Map

MOD 512

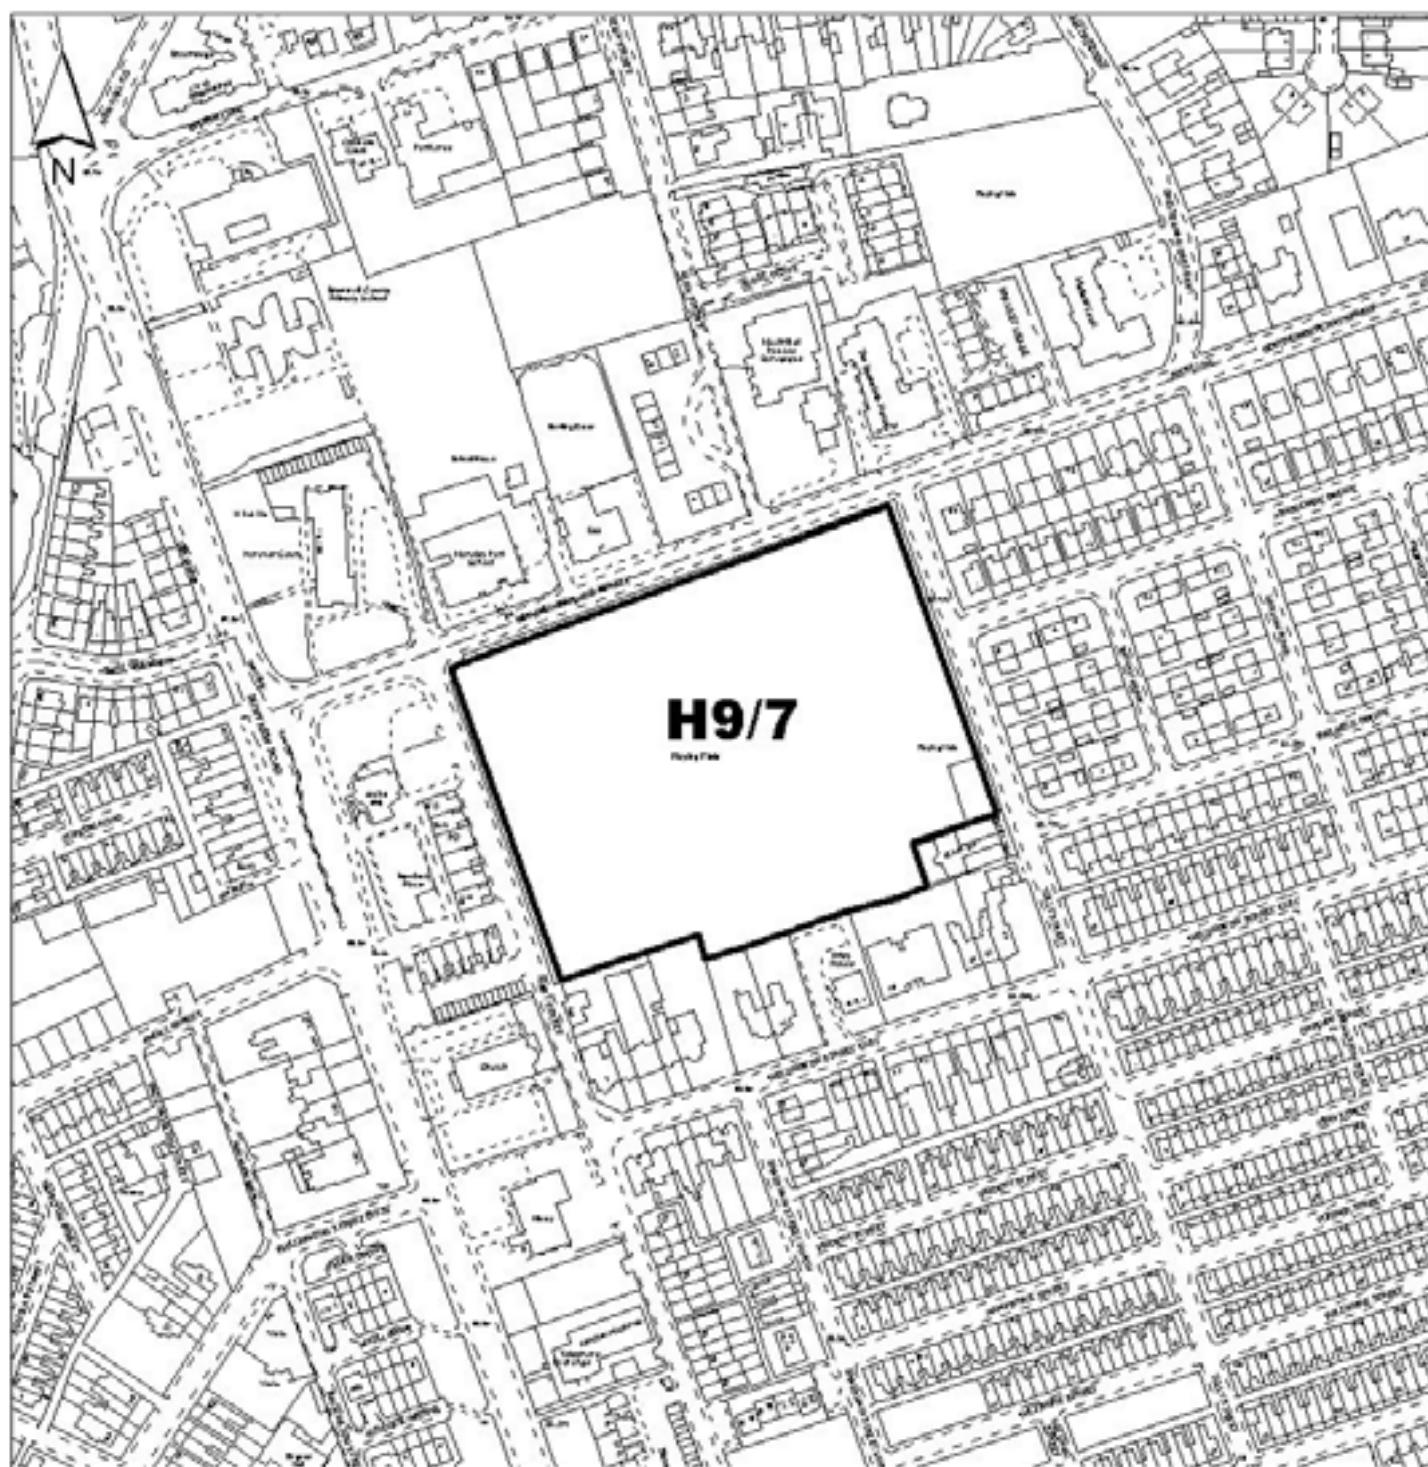

Salford City Council


Development Planning Section,
Development Services,
Salford Civic Centre, Chorley Rd,
Swinton, Salford M27 0BW.
www.salford.gov.uk

Job:	Project:	Drawing No.:
Drawn:		
Checked:		
Scale: 1:3000	Title:	
Date: Oct 2005		Revision:
Filename: UDPMOD		

CITY OF SALFORD UNITARY DEVELOPMENT PLAN REVIEW PROPOSED MODIFICATION TO THE PROPOSALS MAP

- Address: Land at Hayes Road, Cadishead
- Policy: Policy H9/8
- Modification: Delete the policy from the Proposals Map

MOD 513

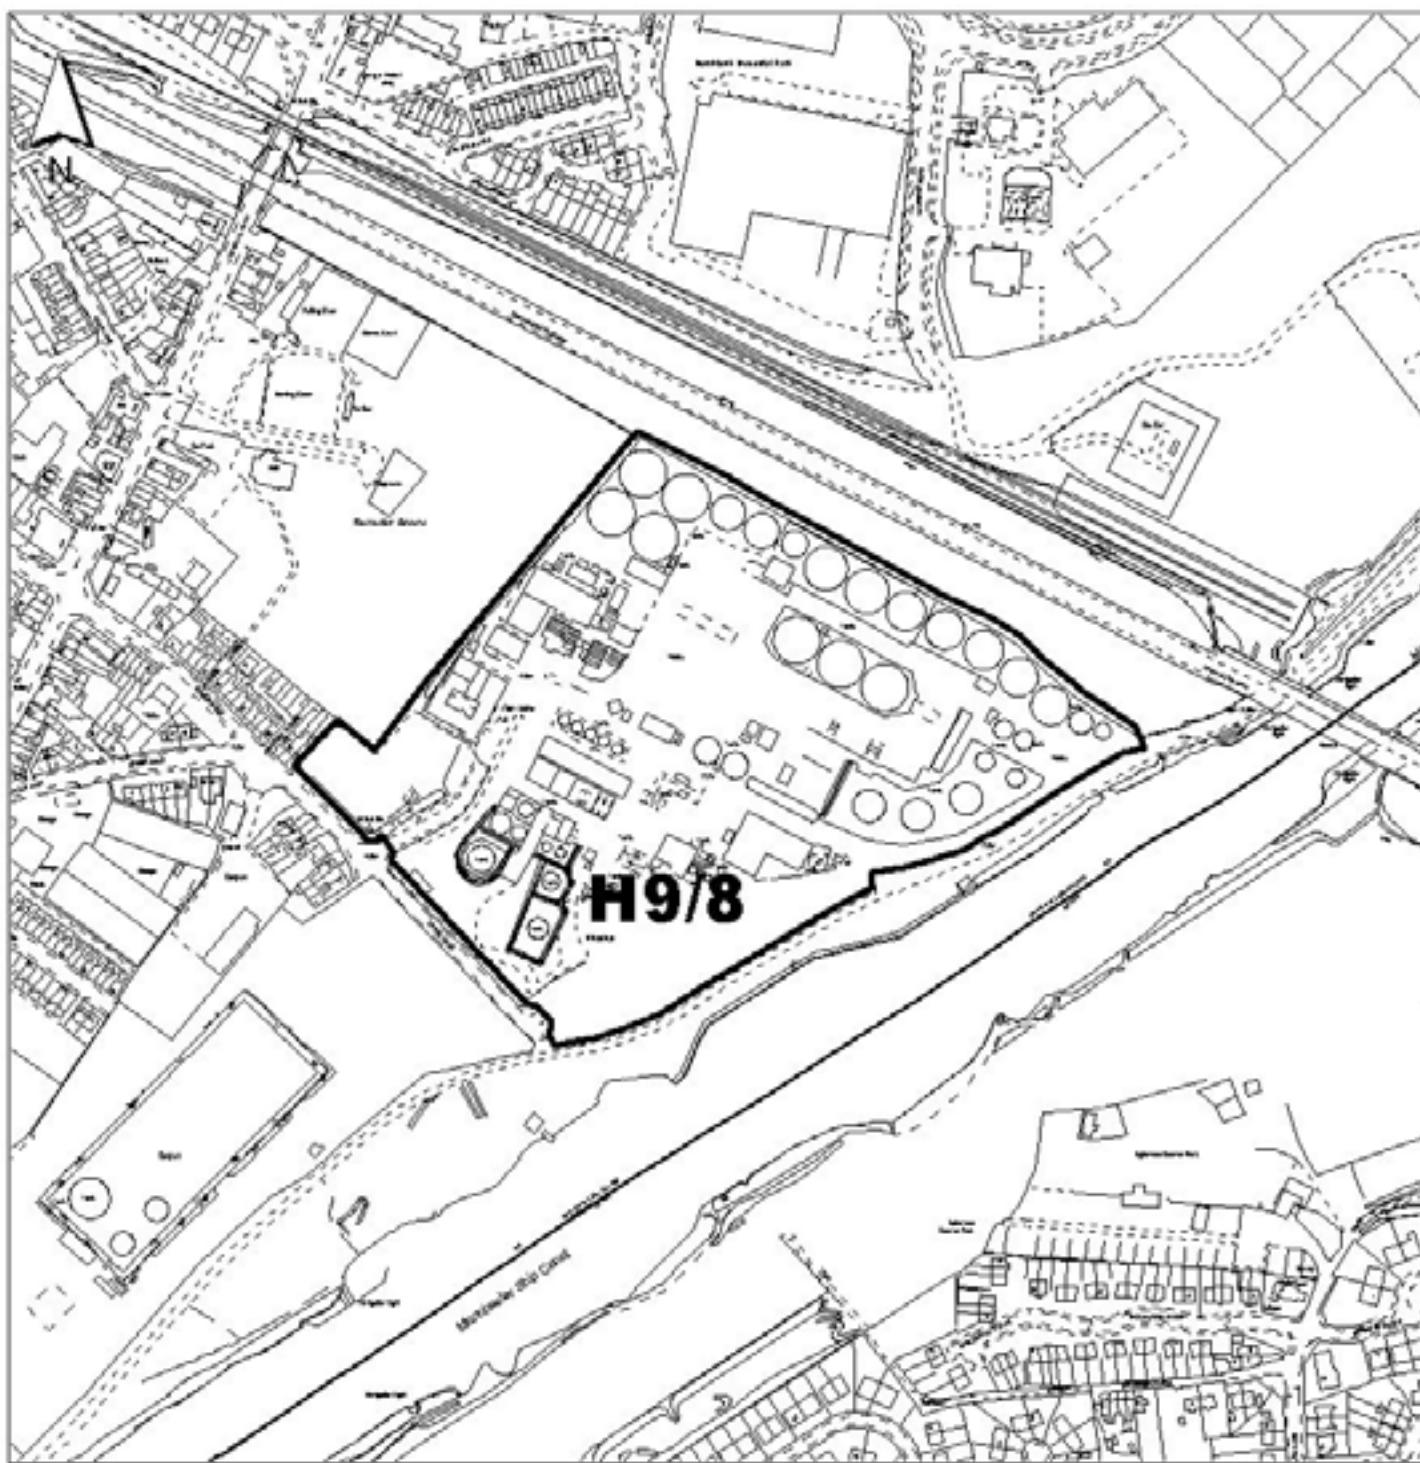

Salford City Council

Development Planning Section,
Development Services,
Salford Civic Centre, Chorley Rd,
Swinton, Salford M27 6BW,
www.salford.gov.uk

Job:	Project:	Drawing No.
Drawn:		
Checked:		
Scale: 1:4000		
Date: Oct 2005		
Filename: UDPMOD		
	Title:	Revision


*Reproduced from the Ordnance Survey mapping with the permission of the Controller of Her Majesty's Stationery Office © Crown copyright.
Unauthorised reproduction infringes Crown copyright and may lead to prosecution or civil proceedings. Salford City Council Licence No. 100019737. 2004.

UDP modification to proposals map

CITY OF SALFORD UNITARY DEVELOPMENT PLAN REVIEW PROPOSED MODIFICATION TO THE PROPOSALS MAP

- Address: Former Greenwood School, Stafford Road, Ellesmere Park, Eccles
- Policy: Policy H9/10
- Modification: Delete the policy from the Proposals Map

MOD 514

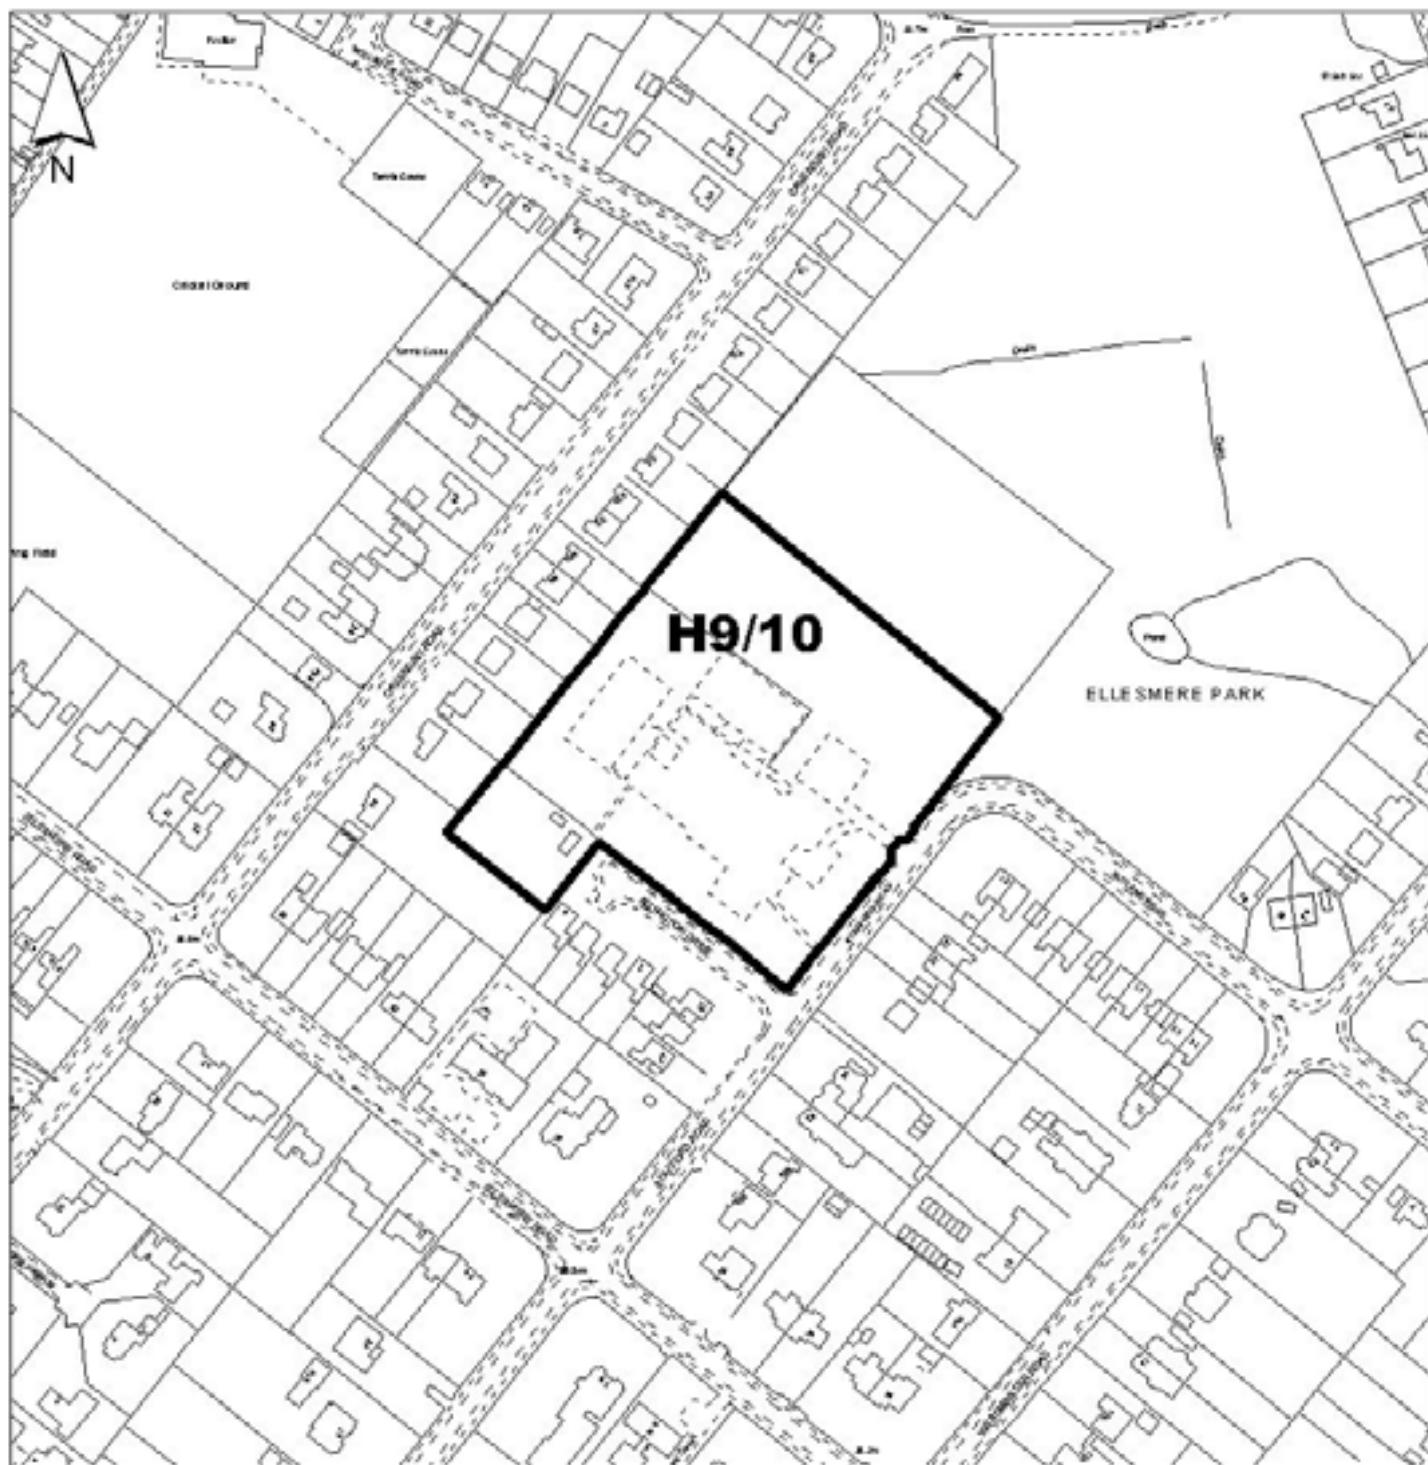

Salford City Council


Development Planning Section,
Development Services,
Salford Civic Centre, Chorley Rd,
Swinton, Salford M27 5BW.
www.salford.gov.uk

Job:	Project:	Drawing No.:
Drawn:		
Checked:		
Scale: 1:2500	Title:	
Date: Oct 2005		Revision:
Filename: UDPMOD		

CITY OF SALFORD UNITARY DEVELOPMENT PLAN REVIEW PROPOSED MODIFICATION TO THE PROPOSALS MAP

- Address: Former Kersal High School, Moor Lane, Kersal
- Policy: Policy H9/11
- Modification: Delete the policy from the Proposals Map

MOD 515

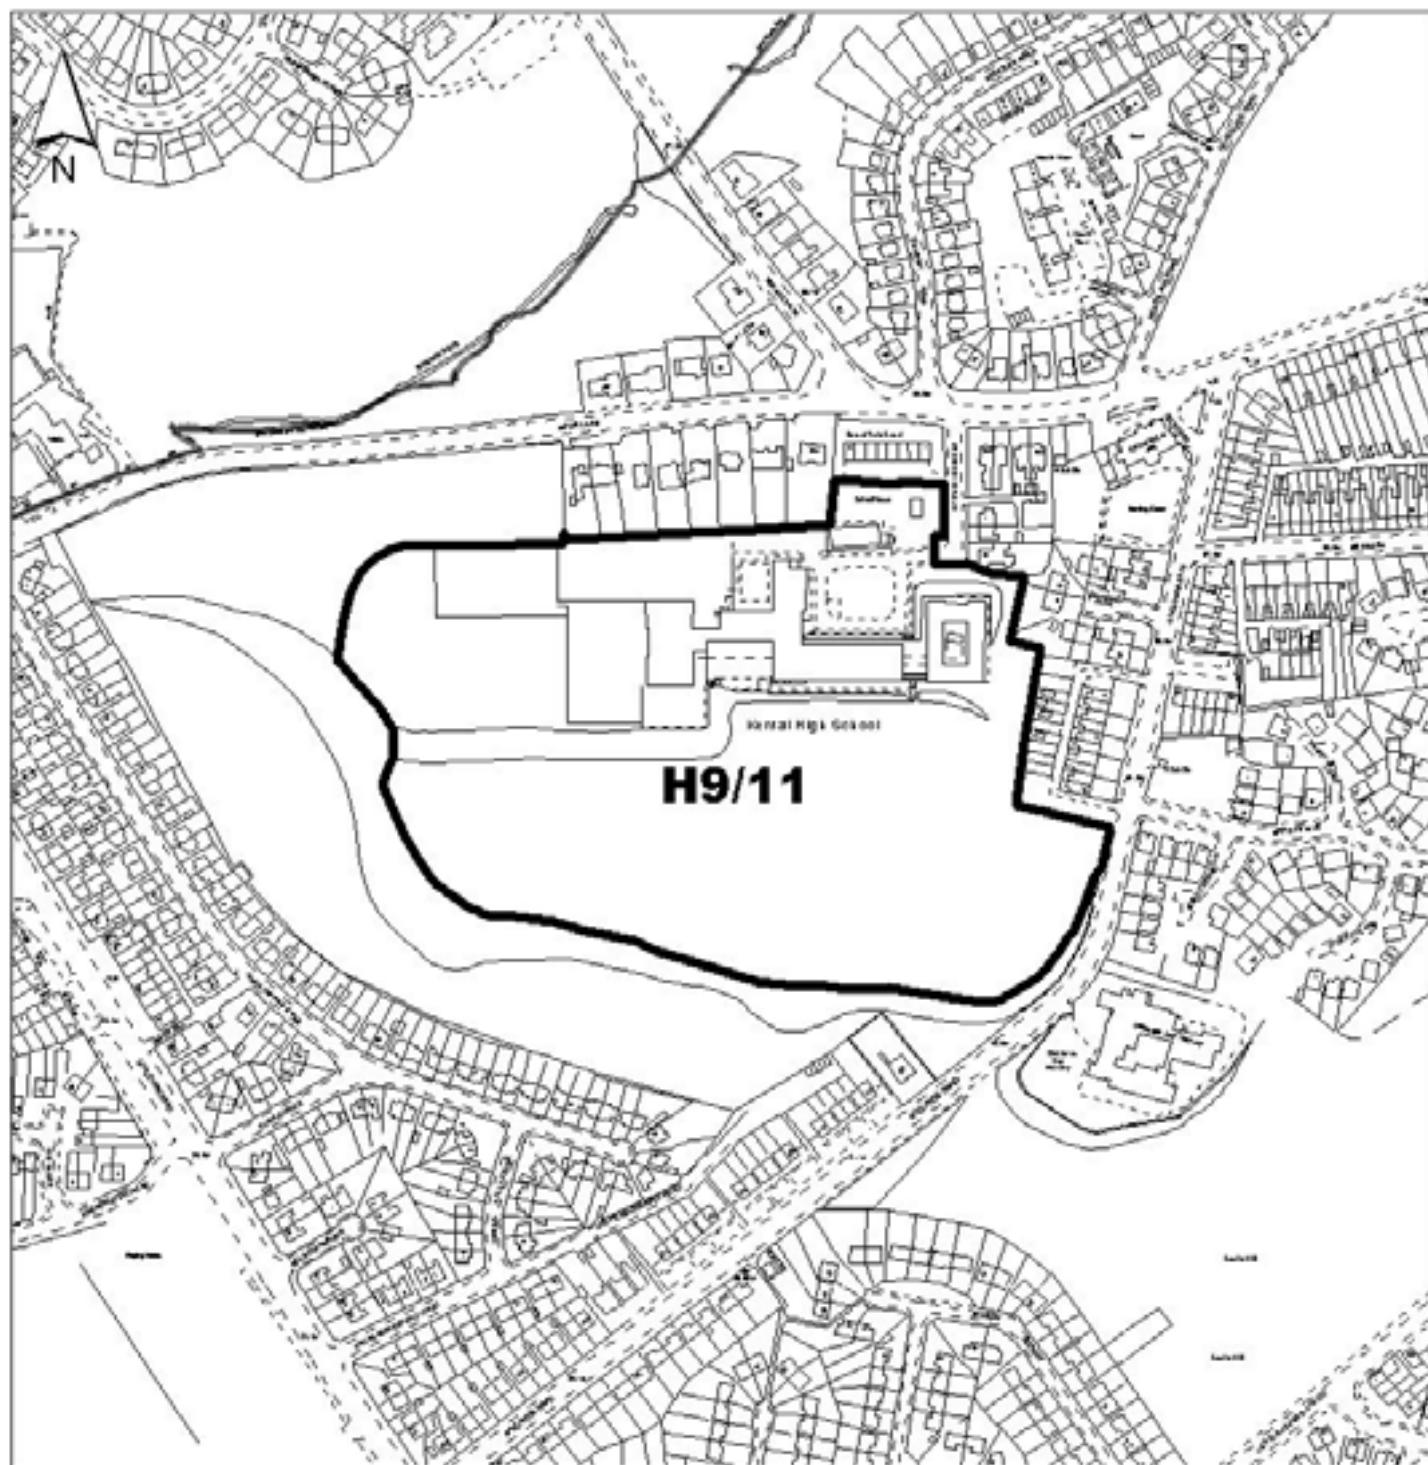

Salford City Council

Development Planning Section,
Development Services,
Salford Civic Centre, Chorley Rd,
Swinton, Salford M27 5BW.
www.salford.gov.uk

Job:	Project:	Drawing No.:
Drawn:		
Checked:		
Scale: 1:3500	Title:	
Date: Oct 2005		Revision:
Filename: UDPMOD		


'Reproduced from the Ordnance Survey mapping with the permission of the Controller of Her Majesty's Stationery Office © Crown copyright.
Unauthorised reproduction infringes Crown copyright and may lead to prosecution or civil proceedings. Salford City Council Licence No. 100019737. 2004.

Map modifications to proposals map ap1

CITY OF SALFORD UNITARY DEVELOPMENT PLAN REVIEW PROPOSED MODIFICATION TO THE PROPOSALS MAP

- Address: Kersal Way / Kingsley Avenue, Kersal
- Policy: Policy H9/12
- Modification: Delete the policy from the Proposals Map

MOD 516

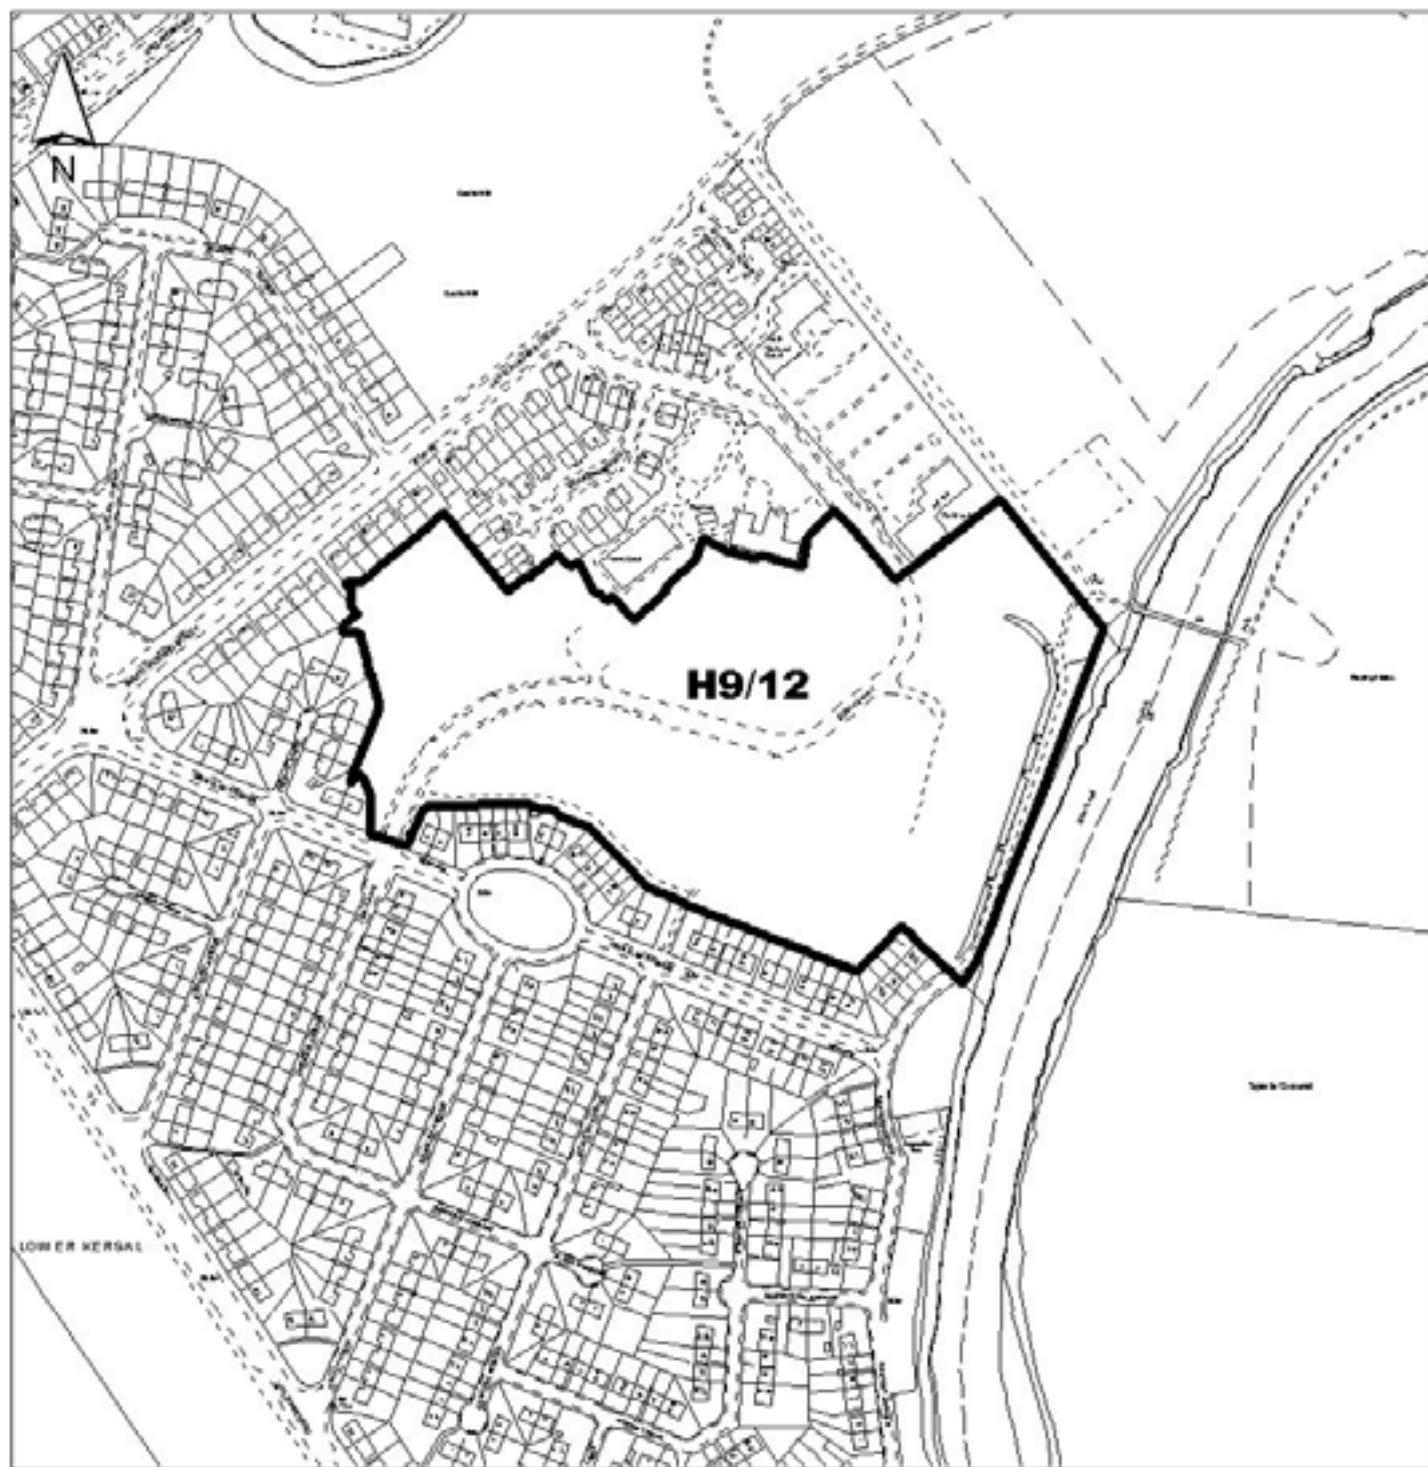

Salford City Council


Development Planning Section,
Development Services,
Salford Civic Centre, Chorley Rd,
Swinton, Salford M27 5BW.
www.salford.gov.uk

Job:	Project:	Drawing No.:
Drawn:		
Checked:		
Scale 1:3500	Title:	
Date Oct 2005		Revision:
Filename: UDPMOD		

CITY OF SALFORD UNITARY DEVELOPMENT PLAN REVIEW PROPOSED MODIFICATION TO THE PROPOSALS MAP

- Address: Land at Amblecote Drive, Little Hulton
- Policy: Policy H9/14
- Modification: Delete the policy from the Proposals Map

MOD 517

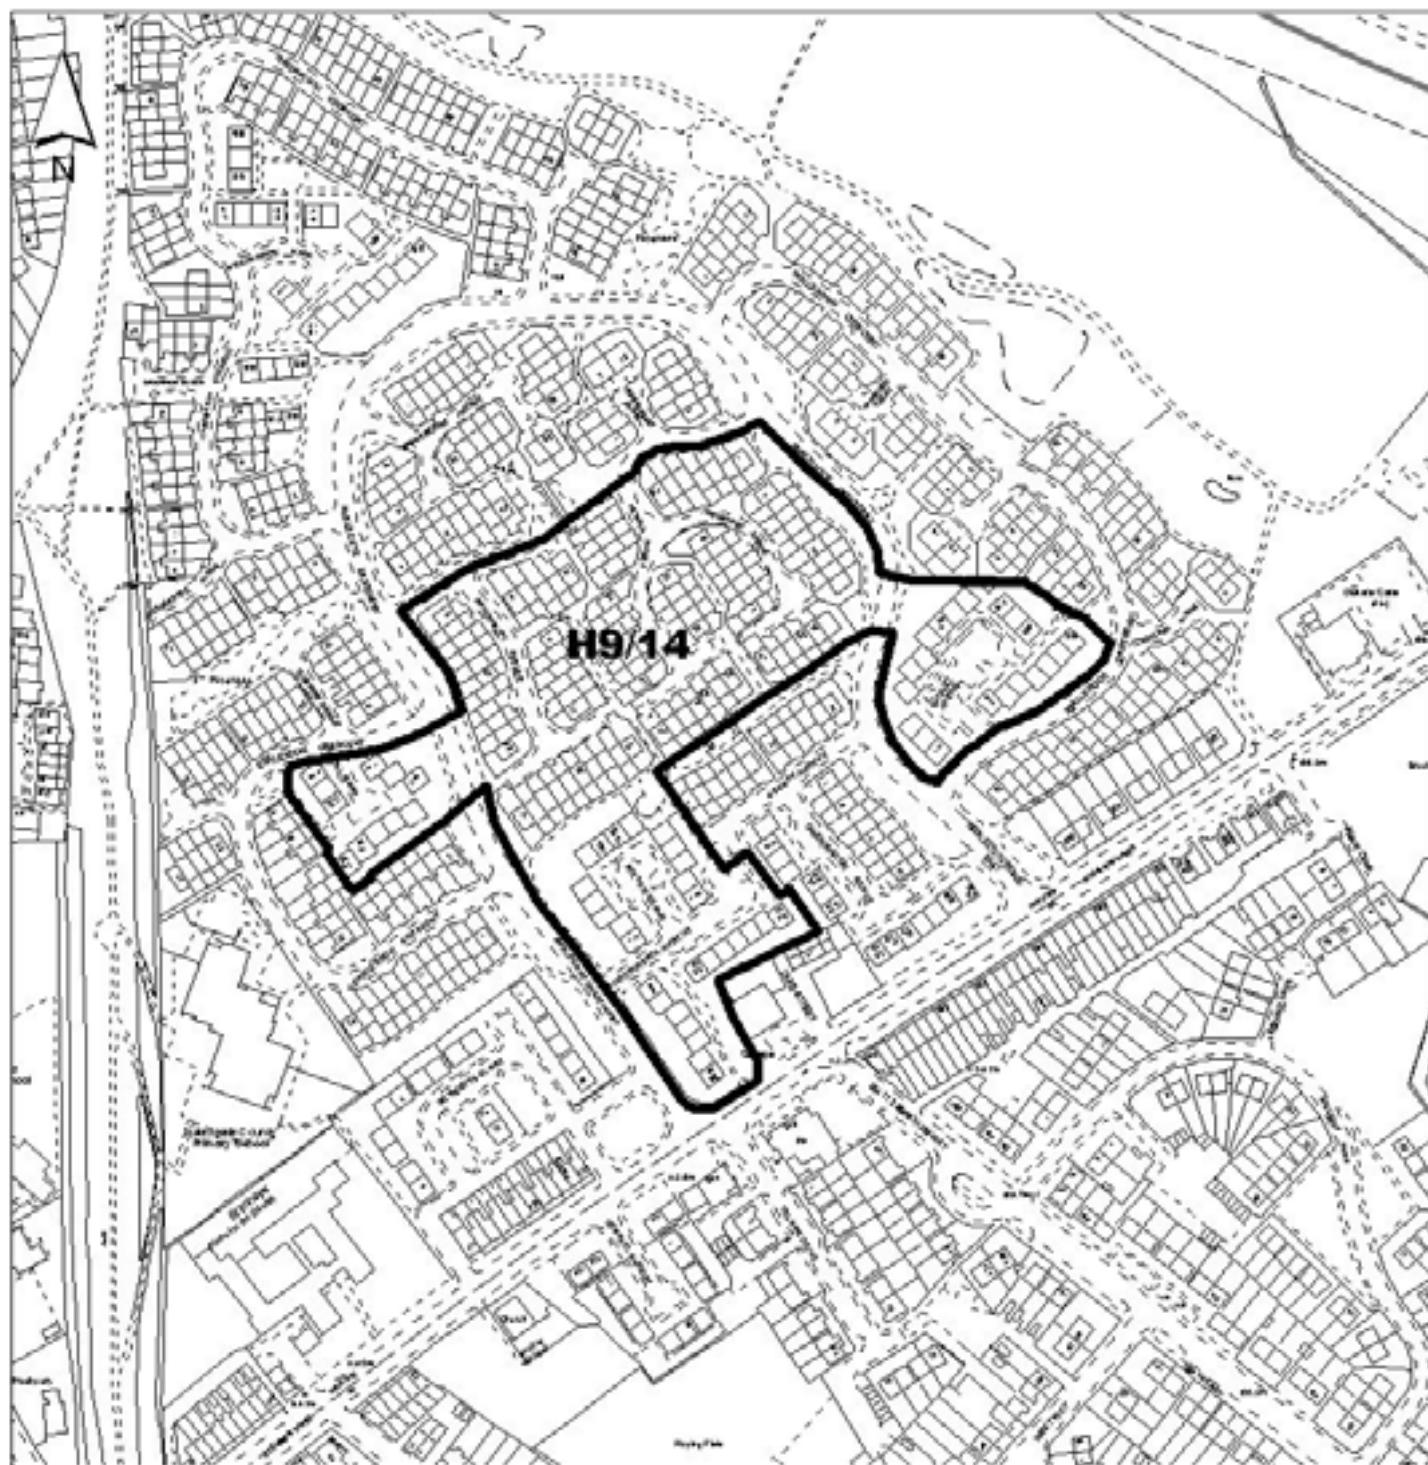

Salford City Council


Development Planning Section,
Development Services,
Salford Civic Centre, Chorley Rd,
Swinton, Salford M27 8BW.
www.salford.gov.uk

Job:	Project:	Drawing No.:
Drawn:		
Checked:		
Scale: 1:3000	Title:	
Date: Oct 2005		Revision:
Filename: UDPMOD		

CITY OF SALFORD UNITARY DEVELOPMENT PLAN REVIEW PROPOSED MODIFICATION TO THE PROPOSALS MAP

- Address: Hulton Street / Pheobe Street, Ordsall
- Policy: Policy H9/15
- Modification: Delete the policy from the Proposals Map

MOD 518

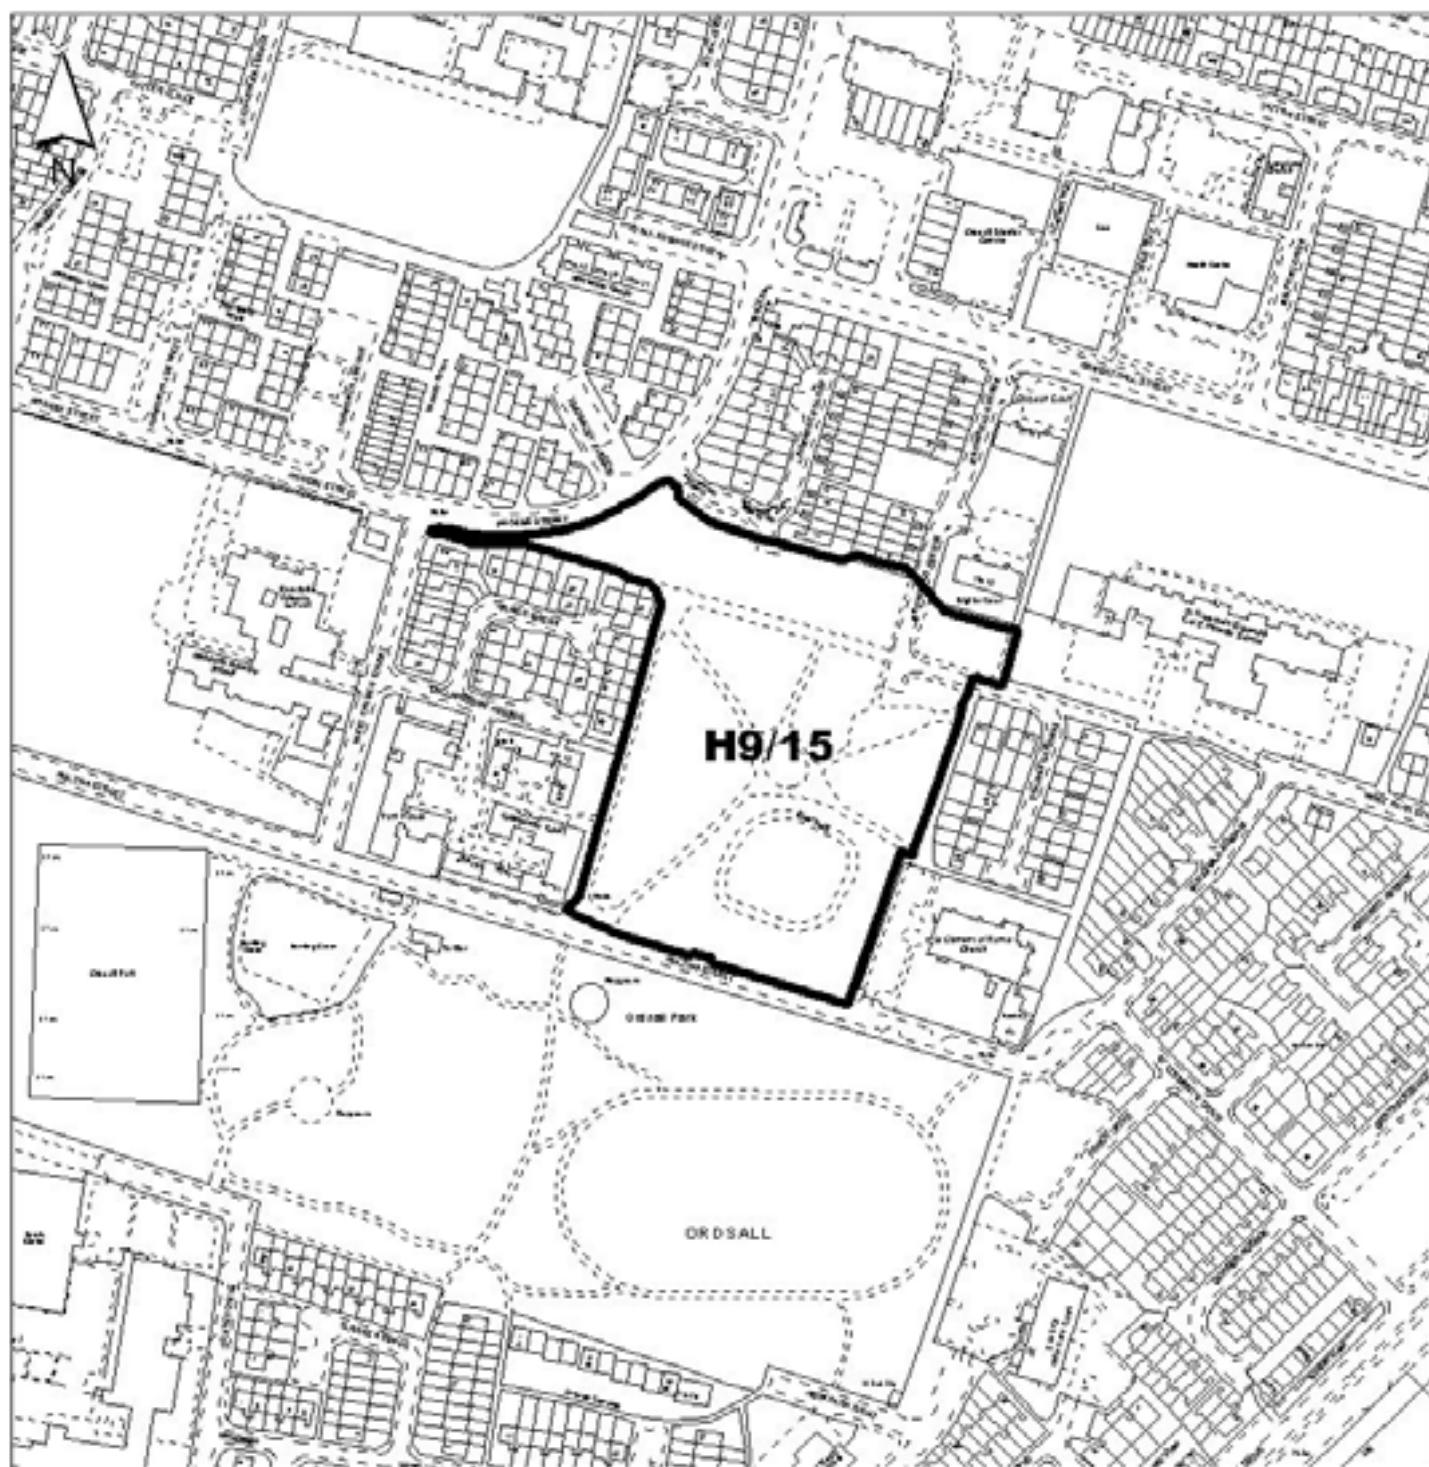

Salford City Council


Development Planning Section,
Development Services,
Salford Civic Centre, Chorley Rd,
Swinton, Salford M27 8BW.
www.salford.gov.uk

Job:	Project:	Drawing No.:
Drawn:		
Checked:		
Scale: 1:3000	Title:	
Date: Oct 2005		Revision:
Filename: UDPMOD		

CITY OF SALFORD UNITARY DEVELOPMENT PLAN REVIEW PROPOSED MODIFICATION TO THE PROPOSALS MAP

- Address: Former Clifton Green Flats, The Green, Pendlebury
- Policy: Policy H9/16
- Modification: Delete the policy from the Proposals Map

MOD 519

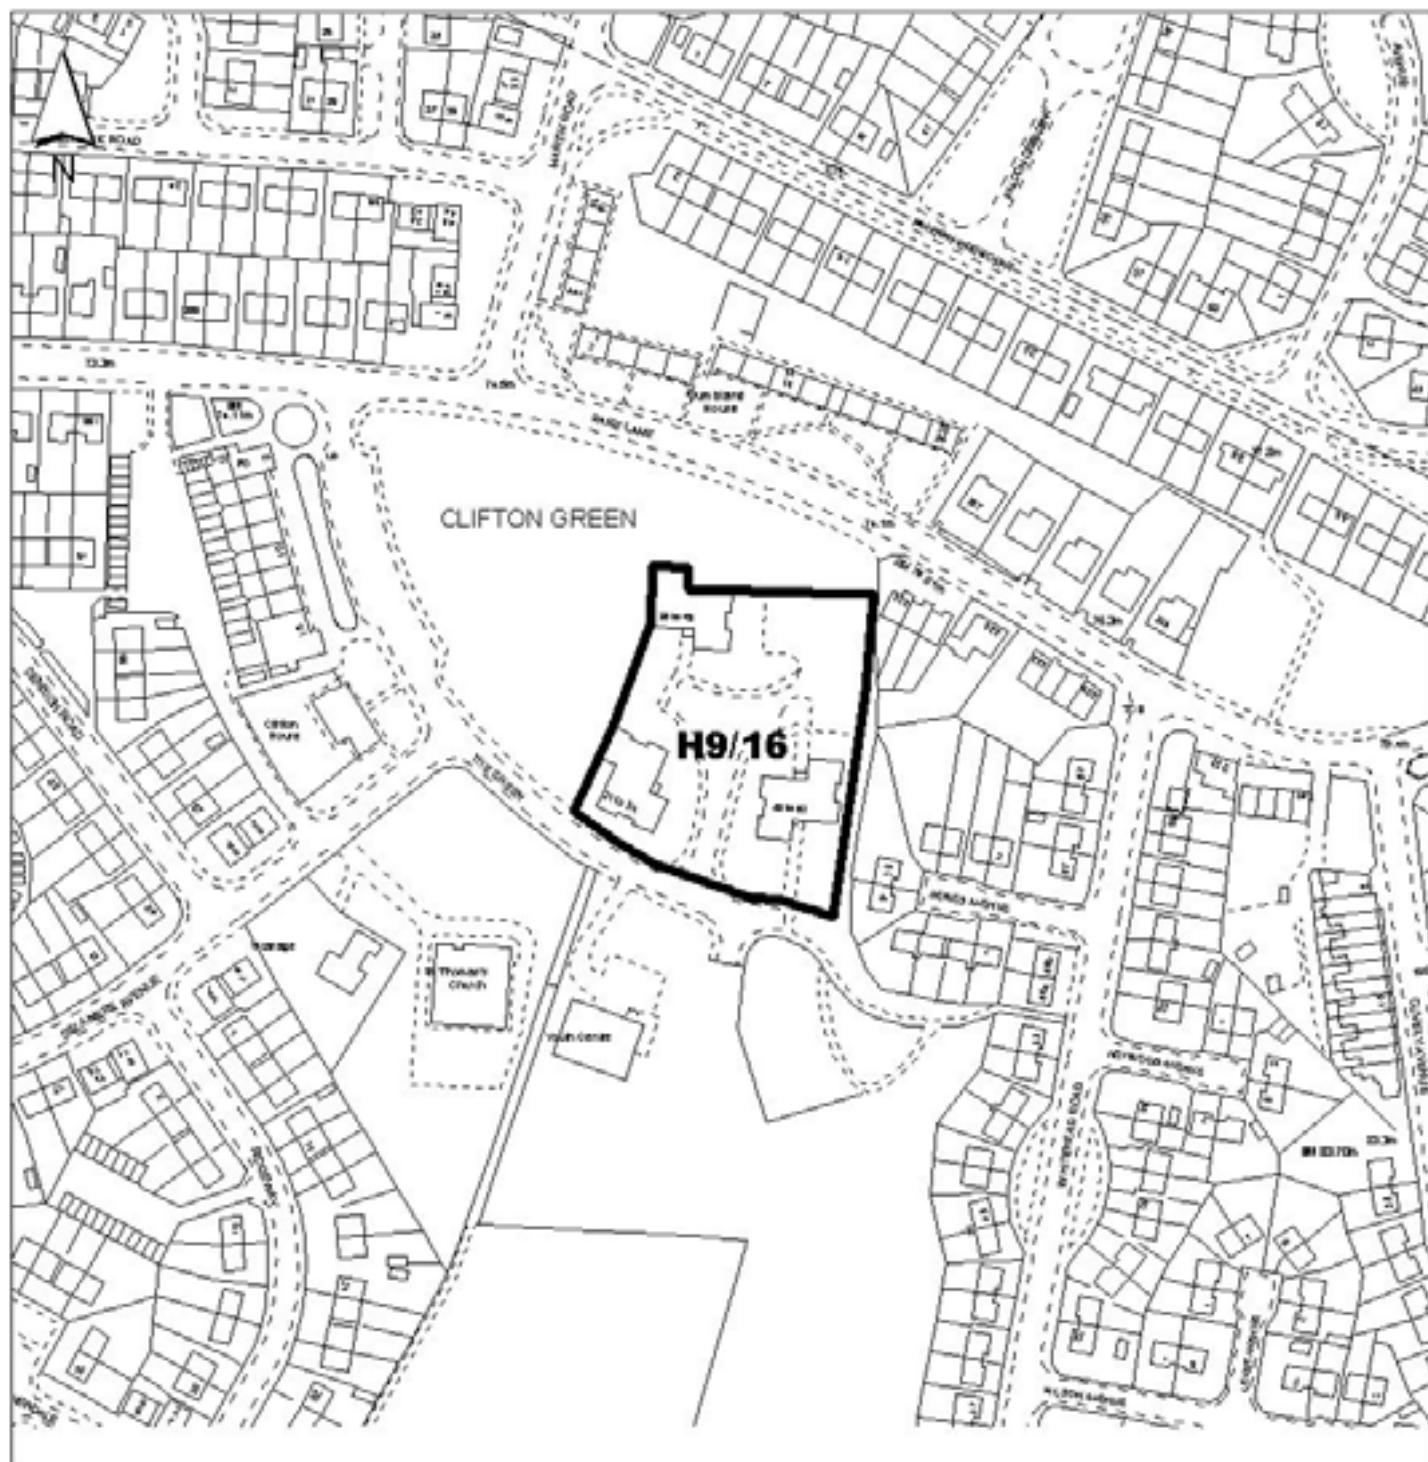

Salford City Council

Development Planning Section,
Development Services,
Salford Civic Centre, Chorley Rd,
Swinton, Salford M27 8BW.
www.salford.gov.uk

Job:	Project:	Drawing No.:
Drawn:		
Checked:		
Scale: 1:2000	Title:	
Date: Oct 2005		Revision:
Filename: UDPMOD		